



---

**west virginia** department of environmental protection

---

Office of Oil and Gas  
601 57th Street SE  
Charleston, WV 25304  
(304) 926-0450  
(304) 926-0452 fax

Earl Ray Tomblin, Governor  
Randy C. Huffman, Cabinet Secretary  
[www.dep.wv.gov](http://www.dep.wv.gov)

July 31, 2015

**WELL WORK PERMIT**


**Horizontal 6A Well**

This permit, API Well Number: 47-10303130, issued to SWN PRODUCTION COMPANY, LLC, is evidence of permission granted to perform the specified well work at the location described on the attached pages and located on the attached plat, subject to the provisions of Chapter 22 of the West Virginia Code of 1931, as amended, and all rules and regulations promulgated thereunder, and to all conditions and provisions outlined in the pages attached hereto. Notification shall be given by the operator to the Oil and Gas Inspector at least 24 hours prior to the construction of roads, locations, and/or pits for any permitted work. In addition, the well operator shall notify the same inspector 24 hours before any actual well work is commenced and prior to running and cementing casing. Spills or emergency discharges must be promptly reported by the operator to 1-800-642-3074 and to the Oil and Gas inspector.

Please be advised that form WR-35, Well Operators Report of Well Work is to be submitted to this office within 90 days completion of permitted well work, as should form WR-34 Discharge Monitoring Report within 30 days of discharge of pits, if applicable. Failure to abide by all statutory and regulatory provisions governing all duties and operations hereunder may result in suspension or revocation of this permit and, in addition, may result in civil and/or criminal penalties being imposed upon the operators.

In addition to the applicable requirements of this permit, and the statutes and rules governing oil and gas activity in WV, this permit may contain specific conditions which must be followed. Permit conditions are attached to this cover letter.

Per 35CSR-4-5.2.g this permit will expire in two (2) years from the issue date unless permitted well work is commenced. If there are any questions, please feel free to contact me at (304) 926-0499 ext. 1654.

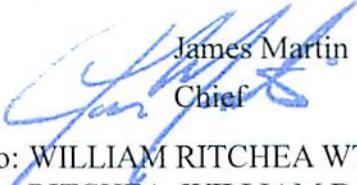  
James Martin  
Chief

Operator's Well No: WILLIAM RITCHEA WTZ 201H  
Farm Name: RITCHEA, WILLIAM D. & SHIRLI

**API Well Number: 47-10303130**

**Permit Type: Horizontal 6A Well**

Date Issued: 07/31/2015

**Promoting a healthy environment.**

## PERMIT CONDITIONS

West Virginia Code § 22-6A-8(d) allows the Office of Oil and Gas to place specific conditions upon this permit. Permit conditions have the same effect as law. Failure to adhere to the specified permit conditions may result in enforcement action.

### CONDITIONS

---

1. This proposed activity may require permit coverage from the United States Army Corps of Engineers (USACE). Through this permit, you are hereby being advised to consult with USACE regarding this proposed activity.
2. If the operator encounters an unanticipated void, or an anticipated void at an unanticipated depth, the operator shall notify the inspector within 24 hours. Modifications to the casing program may be necessary to comply with W. Va. Code § 22-6A-5a (12), which requires drilling to a minimum depth of thirty feet below the bottom of the void, and installing a minimum of twenty (20) feet of casing. Under no circumstance should the operator drill more than one hundred (100) feet below the bottom of the void or install less than twenty (20) feet of casing below the bottom of the void.
3. When compacting fills, each lift before compaction shall not be more than 12 inches in height, and the moisture content of the fill material shall be within limits as determined by the Standard Proctor Density test of the actual soils used in specific engineered fill, ASTM D698, Standard Test Method for Laboratory Compaction Characteristics of Soil Using Standard Effort, to achieve 95 % compaction of the optimum density. Each lift shall be tested for compaction, with a minimum of two tests per lift per acre of fill. All test results shall be maintained on site and available for review.
4. Operator shall install signage per § 22-6A-8g (6) (B) at all source water locations included in their approved water management plan within 24 hours of water management plan activation.
5. Oil and gas water supply wells will be registered with the Office of Oil and Gas and all such wells will be constructed and plugged in accordance with the standards of the Bureau for Public Health set forth in its Legislative rule entitled *Water Well Regulations*, 64 C.S.R. 19. Operator is to contact the Bureau of Public Health regarding permit requirements. In lieu of plugging, the operator may transfer the well to the surface owner upon agreement of the parties. All drinking water wells within fifteen hundred feet of the water supply well shall be flow tested by the operator upon request of the drinking well owner prior to operating the water supply well.
6. Pursuant to the requirements pertaining to the sampling of domestic water supply wells/springs the operator shall, no later than thirty (30) days after receipt of analytical data provide a written copy to the Chief and any of the users who may have requested such analyses.
7. If any explosion or other accident causing loss of life or serious personal injury occurs in or about a well or well work on a well, the well operator or its contractor shall give notice, stating the particulars of the explosion or accident, to the oil and gas inspector and the Chief, within 24 hours of said accident.
8. During the casing and cementing process, in the event cement does not return to the surface, the oil and gas inspector shall be notified within 24 hours.
9. Operator shall provide the Office of Oil & Gas notification of the date that drilling commenced on this well. Such notice shall be provided by sending an email to [DEPOOGNotify@wv.gov](mailto:DEPOOGNotify@wv.gov) within 30 days of commencement of drilling.

**STATE OF WEST VIRGINIA**  
**DEPARTMENT OF ENVIRONMENTAL PROTECTION, OFFICE OF OIL AND GAS**  
**WELL WORK PERMIT APPLICATION**

- 1) Well Operator: SWN Production Co., LLC 494512924 103-Wetzel 007-Proc 681- Wileysville  
Operator ID County District Quadrangle
- 2) Operator's Well Number: William Ritchea WTZ 201H Well Pad Name: William Ritchea WTZ Pad
- 3) Farm Name/Surface Owner: William D. & Shirley E. Ritchea Public Road Access: Harland Ridge
- 4) Elevation, current ground: 1563.3' Elevation, proposed post-construction: 1563.4'
- 5) Well Type (a) Gas  Oil  Underground Storage   
Other \_\_\_\_\_  
(b) If Gas Shallow  Deep   
Horizontal
- 6) Existing Pad: Yes or No yes
- 7) Proposed Target Formation(s), Depth(s), Anticipated Thickness and Associated Pressure(s):  
Target Formation- Marcellus, Target Top TVD- 7530', Target Base TVD- 7577', Anticipated Thickness- 47' Associated Pressure- 4800
- 8) Proposed Total Vertical Depth: 7556'
- 9) Formation at Total Vertical Depth: Marcellus
- 10) Proposed Total Measured Depth: 16,243'
- 11) Proposed Horizontal Leg Length: 6882.62'
- 12) Approximate Fresh Water Strata Depths: 519'
- 13) Method to Determine Fresh Water Depths: USGS well tops data
- 14) Approximate Saltwater Depths: 770'
- 15) Approximate Coal Seam Depths: 1476'
- 16) Approximate Depth to Possible Void (coal mine, karst, other): None that we are aware of.
- 17) Does Proposed well location contain coal seams directly overlying or adjacent to an active mine? Yes \_\_\_\_\_ No
- (a) If Yes, provide Mine Info: Name: \_\_\_\_\_  
Depth: \_\_\_\_\_  
Seam: \_\_\_\_\_  
Owner: \_\_\_\_\_

18)

**CASING AND TUBING PROGRAM**

TYPE	Size (in)	New or Used	Grade	Weight per ft. (lb/ft)	FOOTAGE: For Drilling (ft)	INTERVALS: Left in Well (ft)	CEMENT: Fill-up (Cu. Ft.)/CTS
Conductor	20"	New	H-40	94#	100'	100'	CTS
Fresh Water	13 3/8"	New	J-55	54.5#	649'	649'	767 sx/CTS
Coal	9 5/8"	New	J-55	40#	2969'	2969'	1123 sx/CTS
Intermediate	7"	New	J-55	20#	If Needed	If Needed	If Needed/As Needed
Production	5 1/2"	New	HCP-110	20#	16,243'	16,243'	Less 12000 Cu. Ft. or 10000 lbs
Tubing	2 3/8"	New	P-110	4.7#	Approx. 7556'	Approx. 7556'	
Liners							

TYPE	Size (in)	Wellbore Diameter (in)	Wall Thickness (in)	Burst Pressure (psi)	Max. Associated Surface Pressure (psi)	Cement Type	Cement Yield (cu. ft./k)
Conductor	20"	30"	0.25	2120	81	Class A	1.19/50% Excess
Fresh Water	13 3/8"	17.5"	0.380	2740	633	Class A	1.19/50% Excess
Coal	9 5/8"	12 1/4"	0.395	3950	1768	Class A	1.19/50% Excess
Intermediate	7"	8 3/4"	0.317	4360	3250	Class A	1.20/15% Excess
Production	5 1/2"	8 3/4"	0.361	12360	9500	Class A	1.20/15% Excess
Tubing	2 3/8"	4.778"	0.190				
Liners							

**PACKERS**

Kind:	10K Arrowset AS1-X			
Sizes:	5 1/2"			
Depths Set:				

19) Describe proposed well work, including the drilling and plugging back of any pilot hole:

Drill and stimulate any potential zones between and including the Benson to Marcellus. \*\*If we should encounter a void place basket above and below void area- balance cement to bottom of void and grout from basket to surface. Run casing not less than 20' below void nor more than 50'-75' below void. (\*If freshwater is encountered deeper than anticipated it must be protected, set casing 50'-75' below and cts.)

20) Describe fracturing/stimulating methods in detail, including anticipated max pressure and max rate:

Well will be perforated within the target formation and stimulated with a slurry of water, sand, and chemical additives at a high rate. This will be performed in stages with the plug and perf method along the wellbore until the entire lateral has been stimulated within the target formation. All stage plugs are then drilled out and the well is flowed back to surface. The well is produced through surface facilities consisting of high pressure production unites, vertical separation units, water and oil storage tanks. Max press and anticipated max rate- 9000 lbs @ 80 barrels a minute.

21) Total Area to be disturbed, including roads, stockpile area, pits, etc., (acres): 13.6

22) Area to be disturbed for well pad only, less access road (acres): 9.7

23) Describe centralizer placement for each casing string:

All casing strings will be ran with a centralizer at a minimum of 1 per every 3 joints of casing.

24) Describe all cement additives associated with each cement type:

See Attachment \*\*\*

25) Proposed borehole conditioning procedures:

All boreholes will be conditioned with circulation and rotation for a minimum of one bottom up and continuing until operator is satisfied with borehole conditions.

*Dm4 6-9-15*  
Received  
Office of Oil & Gas  
JUN 15 2015

\*Note: Attach additional sheets as needed.




Production - Lead	D154	low-temperature extender	non-crystalline silica	7631-86-9
	D400	EasyBLOK	boric acid	10043-35-3
	D046	antifoam	Fuller's earth (attapulgite)	8031-18-3
			Polypropylene glycol	25322-69-4
	D201	basic cements enabler	chrystalline silica	14808-60-7
			metal oxide	proprietary
	D202	low-temperature solid dispersant	sulphonated synthetic polymer	proprietary
			formaldehyde (impurity)	50-00-0
	D046	antifoam	Fuller's earth (attapulgite)	8031-18-3
			Polypropylene glycol	25322-69-4
	D167	UNIFLAC* S	aliphatic amide polymer	proprietary
	D065	TIC* Dispersant	Sodium Polynaphthalene Sulfonate	9008-63-3
			Sodium Sulfate	7757-82-6
	D201	basic cements enabler	chrystalline silica	14808-60-7
metal oxide			proprietary	
D153	Anti-Settling Agent	chrystalline silica	14808-60-7	
	<u>SPACER</u>			
B389	MUDPUSH* Express	Carbohydrate	proprietary	
D208	Antifoaming Agent	Silica Organic Polymer	proprietary	
D031	barite	barium sulfate	7727-43-7	
B220	surfactant	fatty acid amine	proprietary	
		ethoxylated alcohol	proprietary	
		glycerol	56-81-5	
		2,2'-Iminodiethanol	111-42-2	

Received  
Office of Oil & Gas  
JUN 15 2015

10303130

Southwestern Energy Company		Proposed Drilling Program	
Well	: WILLIAM RITCHEA WTZ 201	Re-entry Rig	: SDC
Field	: VICTORY FIELD	Prospect	: VICTORY
County	: WETZEL	State	: WV
SHL	: 39.669606 Latitude -80.66267685 Longitude		
BHL	: 39.68018318 Latitude -80.6822931 Longitude		
KB Elev	: 1590 ft MSL		

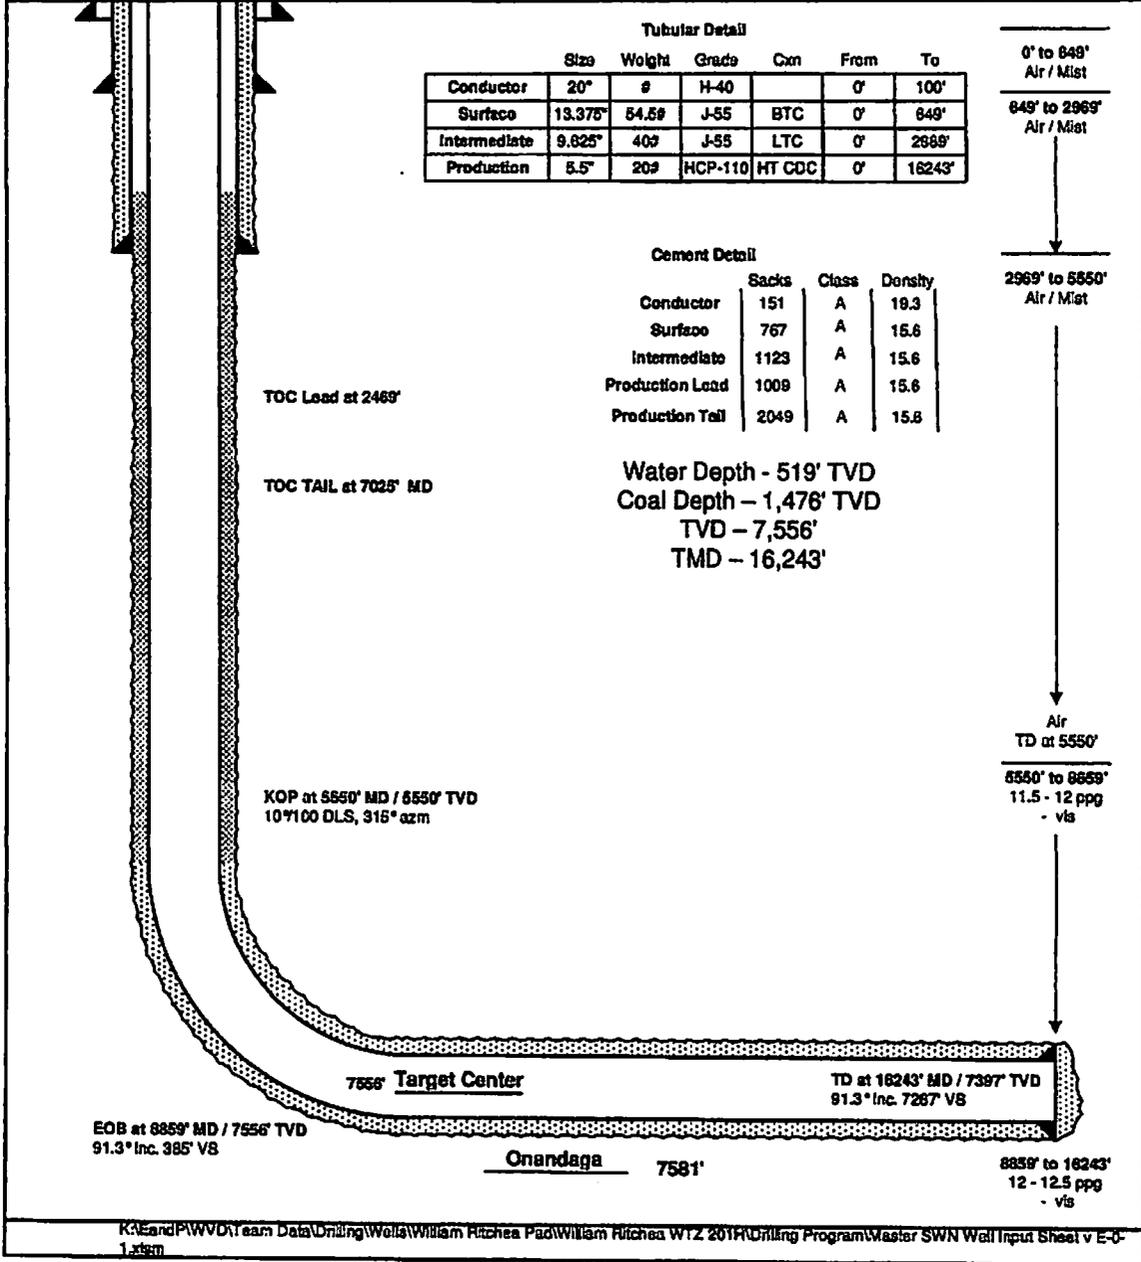

NOTE: This drawing was created for the Reentry Rig. The depths and lengths shown in the plot are referenced to Reentry Rig RIG.

WW-9  
(9/13)

API Number 47 - 69 - -  
Operator's Well No. William Ritchea WTZ 201H

10303130

STATE OF WEST VIRGINIA  
DEPARTMENT OF ENVIRONMENTAL PROTECTION  
OFFICE OF OIL AND GAS

FLUIDS/ CUTTINGS DISPOSAL & RECLAMATION PLAN

Operator Name SWN Production Co., LLC OP Code 49447757

Watershed (HUC 10) Little Fishing Creek Quadrangle 681- Wileyville

Elevation 1563.3' County 103-Wetzel District 7- Proctor

Do you anticipate using more than 5,000 bbls of water to complete the proposed well work? Yes  No

Will a pit be used? Yes  No

If so, please describe anticipated pit waste: closed loop system in place at this time- cuttings will be taken to a permitted landfill.

Will a synthetic liner be used in the pit? Yes  No  If so, what ml.?

Proposed Disposal Method For Treated Pit Wastes:

- Land Application
- Underground Injection ( UIC Permit Number 2D0072539/ 2D0413175/ 2D0610306/ 2D0610317 )
- Reuse (at API Number at next anticipated well, API# will be included with the WR-34/DDMR &/or permit addendum. )
- Off Site Disposal (Supply form WW-9 for disposal location)
- Other (Explain flow back fluids will be put in steel tanks and reused or taken to a permitted disposal facility. )

DMH  
6-9-15

Will closed loop system be used? If so, describe: Yes

Drilling medium anticipated for this well (vertical and horizontal)? Air, freshwater, oil based, etc. Air drill to KOP, Fluid drill with SOB from KOP to TD

-If oil based, what type? Synthetic, petroleum, etc. Synthetic Oil Base

Additives to be used in drilling medium? see attached sheets

Drill cuttings disposal method? Leave in pit, landfill, removed offsite, etc. landfill

-If left in pit and plan to solidify what medium will be used? (cement, lime, sawdust)

-Landfill or offsite name/permit number? meadow SWF- 1032, SS Grading SWF- 4902, Northwestern SWF- 1025, Short Creek 1034/WW0109517/CID28726, Carbon Limestone 28726/CID28726

Arden Landfill 10072, American 02-12954, Country wide 38390/CID38390, Pine Grove 13688

I certify that I understand and agree to the terms and conditions of the GENERAL WATER POLLUTION PERMIT issued on August 1, 2005, by the Office of Oil and Gas of the West Virginia Department of Environmental Protection. I understand that the provisions of the permit are enforceable by law. Violations of any term or condition of the general permit and/or other applicable law or regulation can lead to enforcement action.

I certify under penalty of law that I have personally examined and am familiar with the information submitted on this application form and all attachments thereto and that, based on my inquiry of those individuals immediately responsible for obtaining the information, I believe that the information is true, accurate, and complete. I am aware that there are significant penalties for submitting false information, including the possibility of fine or imprisonment.

Company Official Signature [Signature]

Company Official (Typed Name) Dee Southall

Company Official Title Regulatory Supervisor

Subscribed and sworn before me this 1st day of June, 2015

Brittany R Woody

Notary Public

My commission expires 11/27/2020



10303130

Form WW-9

Operator's Well No. William Ritchea Wtz 201H

SWN Production Co., LLC

Proposed Revegetation Treatment: Acres Disturbed 13.6 Prevegetation pH \_\_\_\_\_

Lime as determined by pH test min. 2 \_\_\_\_\_ Tons/acre or to correct to pH 6.5

Fertilizer type 10-20-20

Fertilizer amount 600 lbs/acre

Mulch Hay/Straw 2.5 Tons/acre


Seed Mixtures

Temporary		Permanent	
Seed Type	lbs/acre	Seed Type	lbs/acre
White Grove	15	White Grove	15
Red Top	15	Red Top	15
Orchard Grass	20	Orchard Grass	20

Attach:

Drawing(s) of road, location, pit and proposed area for land application (unless engineered plans including this info have been provided)

Photocopied section of involved 7.5' topographic sheet.

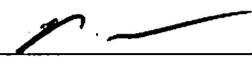Plan Approved by: 

Comments: \_\_\_\_\_

Received  
Office of Oil & Gas  
JUN 15 2015

Title: Oil and Gas Inspector Date: 6-9-15

Field Reviewed?  Yes  No

10303130


**Marcellus Well Drilling Procedures  
And Site Safety Plan**

SWN Production Co., LLC

47 - ~~04~~ -

Well name: William Ritchea WTZ 201H  
Willeyville, Quad  
Proctor, District  
Wetzel County, West Virginia

Submitted by:

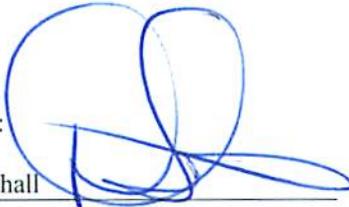

Danielle Southall

5/29/2015

Date:

Title Regulatory Supervisor

SWN Production Co., LLC

Approved by:



Date:

6-9-15

Title: Oil + Gas Inspector

Approved by:

Date:

Title:

SWN Production Co., LLC – Confidential

Received  
Office of Oil & Gas  
JUN 15 2015

10303130

**I. Contacts, Schedules, and Meetings**

A. SWN Production Company, LLC. 24 Hour Hotline: 1-877-879-0376

B(a). Emergency Telephone Numbers:


Agency Type	Name	Phone Number	Cell
County Police	Wetzel County	911 or 304-843-1500	
State Police	Wetzel County	304-843-4100	
Ambulance Service	Wetzel County	911 or 304-843-1500	
Hospital	Wetzel County	304-845-3211	
Fire Department	Wetzel County	911 or 304-842-1500	
Dicky Hall	Drilling Engineer Manager	832-796-7139	
Bill Igou	Drilling Superintendent	570-996-4272	501-654-4161
Danny Brooks	Drilling Superintendent	570-996-4298	501-269-2946
Peter Cain	HSE Field Specialist	281-217-4552	
Derek Cutright	Operations General Manager	281-618-7473	
Chris Flanagan	Production Field Manager	832-796-1626	
Michelle McCracken	Manager HSE	281-618-6284	
Derek Haught	WV Oil and Gas Inspector		304-206-7613
Joe McCourt	Inspector Supervisor		304-380-2467
James Martin	Chief	304-926-0499 x 1654	
Wetzel County OEM	Wetzel County	304-455-6960	
WV DEP	Emergency Pollution and Spills	1-800-642-3074	
Contractor's	Company	Phone	
Well Control Co's	Boots & Coots	1-800-256-9688	
	Halliburton	1-800-409-6479	
Earthwork/Equipment	Triple J Contractors	304-472-3962	
Remediation/Cleanup	Weaverton Environmental	724-746-4850	
Remediation/Cleanup	Ryan Environmental	304-842-5578	
Remediation/Cleanup	Central Environmental Services	304-863-8867	
Heavy Equipment	Kanawha Stone	304-755-8271	
Heavy Equipment/Rouster	Arvilla Pipeline	304-665-2652	
Heavy Equipment	Hoy Contracting	724-627-0272	
Cleanup Supplies	McJunkin Supply	304-472-3565	

Received  
Office of Oil & Gas  
JUN 15 2015





Attachment #3 10303130

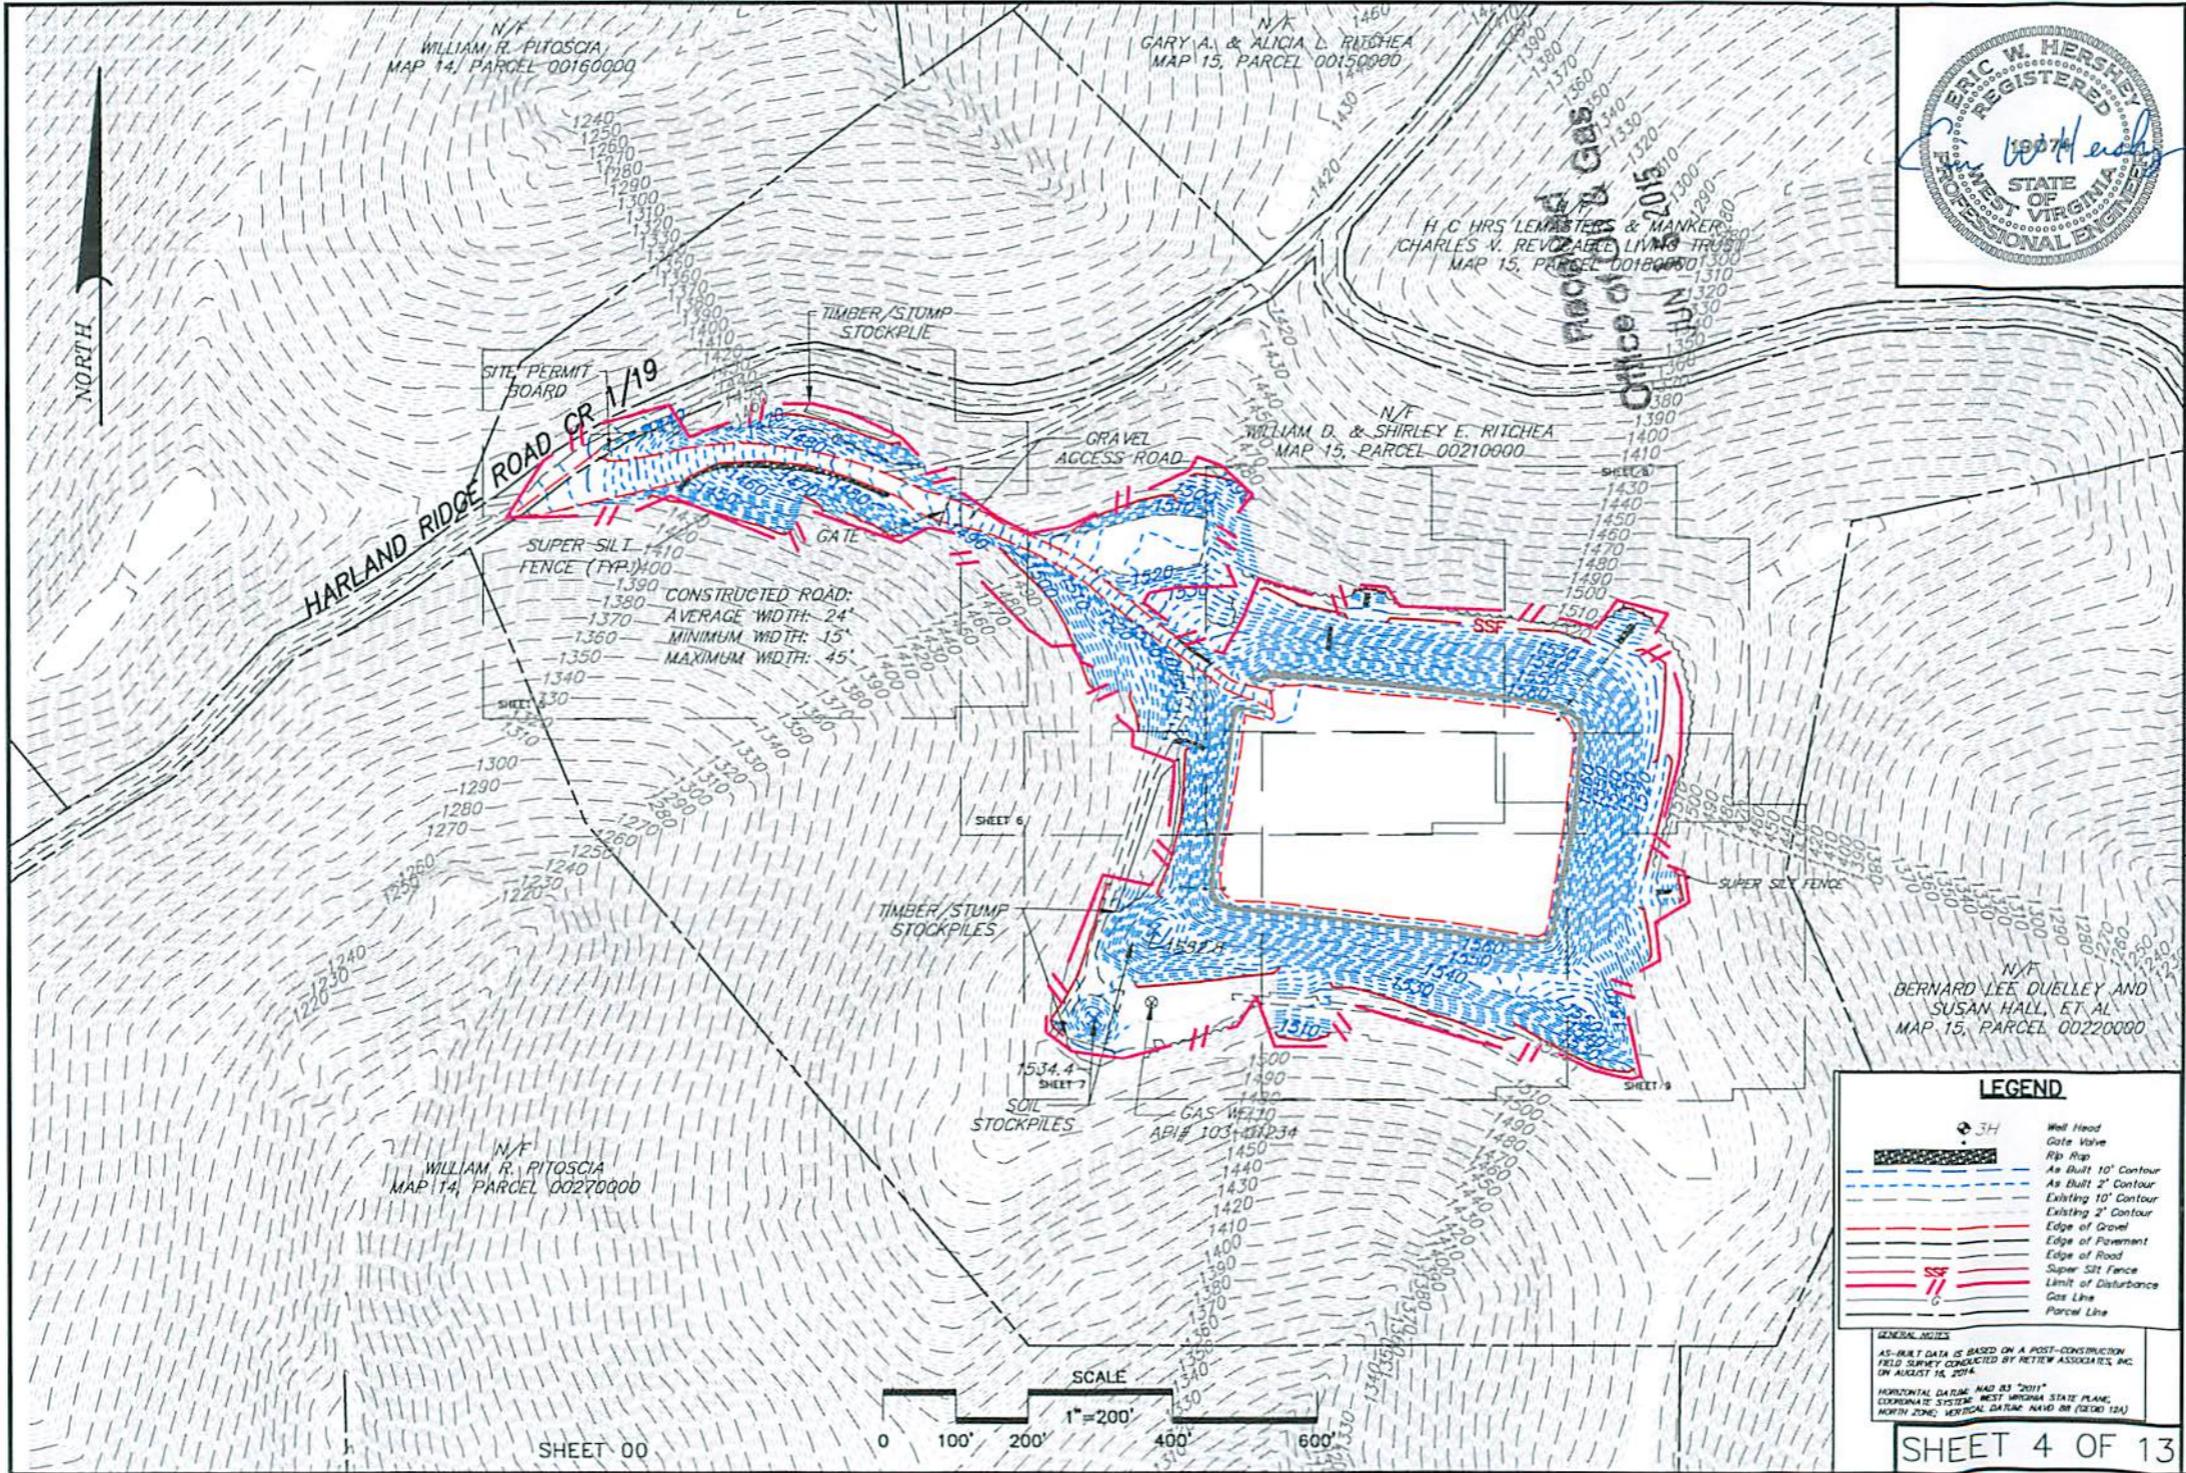

DRAWN BY: JAR  
 DATE: 08/28/2014  
 SCALE: 1" = 200'  
 DWG. NO. 085418003

**RETTEW**  
 RETTEW Associates, Inc.  
 5143 Starshem Road, Suite 100, North Canton, OH 44720  
 Phone (330) 818-9770 • Fax (330) 818-9760  
 Engineers • Planners • Surveyors • Landscape Architects  
 Environmental Consultants


AS-BUILT SITE PLAN OVERVIEW  
 FOR  
**WILLIAM & SHIRLEY RITCHEA  
 WTZ PAD A**  
 WETZEL COUNTY, WV  
 PROCTOR DISTRICT

**LEGEND**

	Well Head
	Gate Valve
	Rip Rap
	As Built 10' Contour
	As Built 2' Contour
	Existing 10' Contour
	Existing 2' Contour
	Edge of Gravel
	Edge of Pavement
	Edge of Road
	Super Silt Fence
	Limit of Disturbance
	Gas Line
	Parcel Line

**GENERAL NOTES**  
 AS-BUILT DATA IS BASED ON A POST-CONSTRUCTION FIELD SURVEY CONDUCTED BY RETTEW ASSOCIATES, INC. ON AUGUST 16, 2014.  
 HORIZONTAL DATUM: NAD 83 "2011"  
 COORDINATE SYSTEM: WEST VIRGINIA STATE PLANE  
 NORTH ZONE; VERTICAL DATUM: NAVD 83 (EGM 96) 12A)

SHEET 4 OF 13

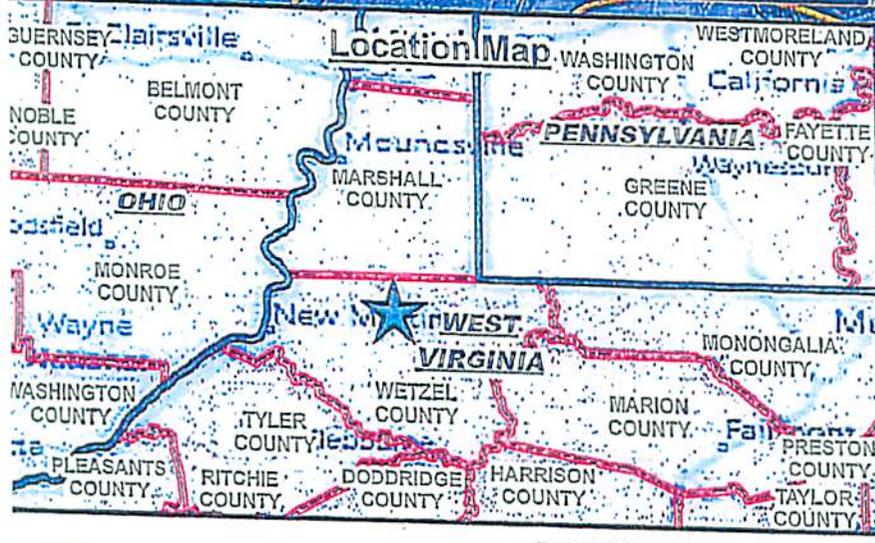

**Legend**

- ★ WILLIAM RITCHEA WTZ PAD
- Commercial Building
- 1 Mile Radius
- County Line

**Scale:** 1:24,000

**Projection:** SPCS West Virginia North (NAD83)

Received  
Office of Oil & Gas  
JUN 15 2015

Attachment #4

10303130

EMERGENCY GATHERING AREA  
(NAD 83)  
LAT: N039° 40' 15.0"  
LONG: W80° 39' 42.0"

HARLAND RIDGE ROAD CR 1/19


PREVAILING WINDS  
→

SITE ENTRANCE  
(NAD 83)  
LAT: N039° 40' 14.7"  
LONG: W80° 39' 48.2"

CENTER OF WELL PAD  
(NAD 83)  
LAT: N039° 40' 10.4"  
LONG: W80° 39' 33.3"

RADIUS 625'  
NO OCCUPIED BUILDINGS INSIDE

 = EVACUATION ROUTE

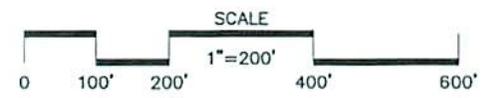

DRAWN BY: JAR  
DATE: 08/28/2014  
SCALE: 1" = 200'  
DWG. NO. 085418003



**RETTEW**  
RETTEW Associates, Inc.  
5143 Stormont Road, Suite 100, North Canton, OH 44720  
Phone (330) 818-9770 • Fax (330) 818-9760  
Engineers • Planners • Environmental Consultants

EVACUATION ROUTE/ PREVAILING WINDS  
FOR  
**WILLIAM & SHIRLEY RITCHEA**  
**WTZ PAD A**  
PROCTOR DISTRICT WEITZEL COUNTY, WV

10303130

A. Well Work and Procedures

1. -Well Work Detail: Drill and stimulate the Marcellus formation. If we should encounter a void, place a basket above and below the void area – balance cement to bottom of void and grout from basket to surface. Run casing not less than 20’ below void nor more than 50-100’ below void. If freshwater is encountered deeper than anticipated it must be protected, set casing at least 50’ below but not more than 100’ below freshwater and cts.
2. -All casing cemented will not be disturbed for at least 8 hours after cementing operations.
3. -Surface, Coal, and Intermediate strings will be pressure tested at a pressure 20% greater than what is expected to be exerted on each string throughout the remainder of the well operations.
4. -No oil or gas production or pressure should exist on the surface or coal protection strings.
5. -A Formation Integrity Test (FIT) will be performed immediately following the drill out of intermediate casing.
6. -Centralizers will be used in the well. However, the placement of the centralizers will be contingent on the final well log and directional data.
7. -Production casing will be pressure tested at a pressure 20% greater than what is expected to be exerted upon it during fracturing operations. Upon completion of fracturing operations the production casing will be pressure tested at a pressure 20% greater than expected shut in pressure.
8. -Well will be perforated within the target formation and stimulated with a slurry of water, sand, and chemical additives at a high rate. This will be performed in stages with the plug and perf method along the wellbore until the entire lateral has been stimulated within the target formation. All stage plugs are then drilled out and the well is flowed back to surface. The well is produced through surface facilities consisting of high pressure production units, vertical separation units, water and oil storage tanks.
9. See Attachment #1

B. A copy of the Site Safety Plan will be provided to the local county emergency office at least 7 days before dirt work or well work commences

Received  
Office of Oil & Gas  
JUN 15 2015

**4. Chemical Inventory & MSDS**





## BLOWOUT PREVENTER SCHEMATIC

WELL :  
 FIELD :  
 RIG :  
 COUNTY :  
 OPERATION : 8 1/2" or 7 1/2" Production Hole

STATE :  
 REVISION : : / /

### Component Descriptions

	Size	Pressure	Description
A	11"	500 psi	Rotating Head
B	11"	5,000 psi	Annular
C	11"	5,000 psi	Pfco Ram
D	11"	5,000 psi	Blind Ram
E	11"	5,000 psi	Mud Cross
F			
G			
H			
DSA			
C Sec			
B Sec		13 3/4" 3M x 11" 5M w/ 6M Gate Valves	
A Sec		13 3/4" SOW x 13 3/4" 3M w/ 3M Gate Valve	

Function	Reference


Trip Tank Required: Yes  No

### Kill Line

ID	Pressure	Description
2 1/16"	5,000 psi	Check Valve
2 1/16"	5,000 psi	Gate Valve
2 1/16"	5,000 psi	Gate Valve

### Choke Line

ID	Pressure	Description
3 1/16"	5,000 psi	Gate Valve
3 1/16"	5,000 psi	HCR Valve
3 1/16"	5,000 psi	Steel or CoFlex Line

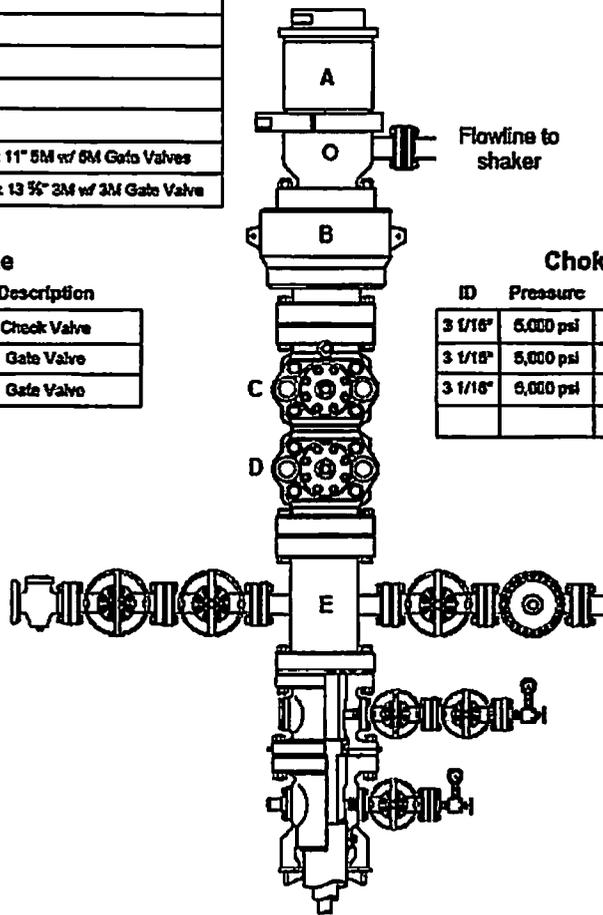

### Testing Requirements

Item	Pressure	Frequency
Rotating Head	250 / 500 psi	Once prior to DO shoe
Annular	250 / 1,500 psi	Every 21 Days
Rams	250 / 5,000 psi	Every 21 Days
Choke Manifold	250 / 5,000 psi	Every 21 Days

• Function test on trips

Approved by \_\_\_\_\_ Date \_\_\_\_\_



Received  
 Office of Oil & Gas

JUN 15 2015

D. The following persons that will be involved in the drilling operations are BOP certified:

Rig Toolpusher  
Rig Morning Tour Driller  
Rig Evening Tour Driller

E-G. See diagram below:

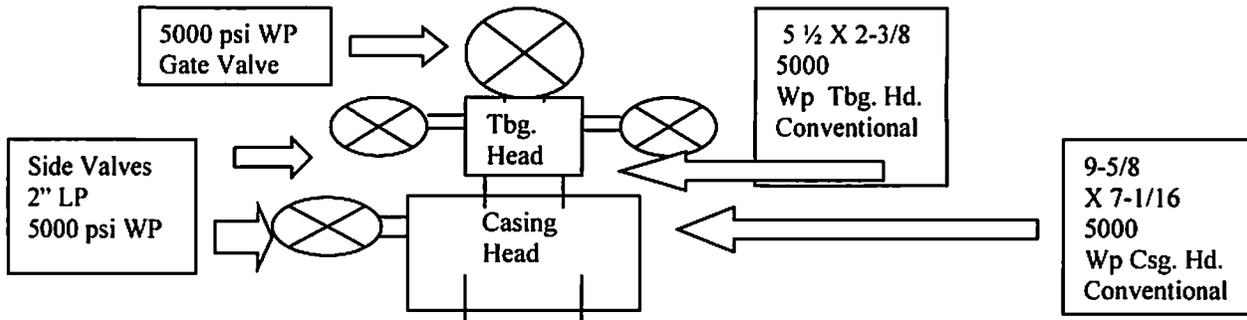

#### H. Well Killing Operations Method and Type

1. Barite and saturated brine will be available if necessary to weight up beyond the proposed compositions. Should a significant gas flow occur, historical data from the field shows that the brine is of sufficient weight to kill the well.
2. No mixing units will be required since only brine would be utilized in the unlikely event of a significant gas show.
3. Once it is confirmed that a significant gas flow has occurred, the wait and weight method will be employed. The mud weight required to kill the well will be calculated and the surface mud system density will be increased to the desired weight. A pumping schedule to circulate the kick out of the well will be calculated and followed once the surface mud system is of proper density.

### 6. Hydrogen Sulfide (H<sub>2</sub>S)

#### 1. A. Safety Equipment

1. (10) 5 – minute escape packs will be installed on the rig floor for a quick escape.
2. (1) 10 – minute escape pack will be installed on the board.
3. (4) 30 – minutes SCBA's will be on-site. Two SCBA's will be placed at the entrance to the location (Muster Point #1) and the other two placed at Muster Point #2 on the other side of the location. This will allow either equipment to be in area that is upwind.
4. (1) 4 – multichannel H<sub>2</sub>S Monitor with sensors placed on the floor, shakers, bell nipple and other to be placed where needed.
5. (2) hand held multi-gas monitor or a box of H<sub>2</sub>S tubes and a box of SO<sub>2</sub> tubes to perform test in the event a monitor has been sounded.
6. (2) Safety Area Signs
7. (1) Condition Sign
8. (2) Wind socks that are to be placed in areas that can be seen at all times on the rig and at an height with good wind flow.

Received  
Office of Oil & Gas

JUN 15 2015

**B. Training**

1. Basic awareness training (either video or booklet review) will occur on-site and may require two trips in order to train all rig crew members
2. Each crew member will be given certification test to verify his competence to respond in an H2S situation.
3. Physically show members how to properly don a mask and perform a qualitative fit test (banana oil) if utilizing a tight fitting mask as an escape unit.
4. Identify and discuss the location of escape units, SCBA's and location of H2S monitors and sensors.

C. In the unlikely event that hydrogen sulfide would be present, all affected residents and agencies would be notified by telephone or in person by a SWN Production Company, LLC representative, and access would be controlled by a sign, color coded flags and a sign-in sheet. Oil and Gas Inspector (Bill Hendershot) will be called at 304-986-3732.

D. In case of an emergency on the drilling site, all persons on location will exit via the access road and meet at the evacuation meeting area designated on the attached EVACUATION PLAN. The highest ranking drilling contractor representative will be responsible for comparing the persons that were present on location to those persons gathered at the designated evacuation meeting area. Any evacuation deemed necessary of residents in the surrounding area will be accomplished by telephone or door-to-door contact from a SWN representative.

E. We will establish Protection Zones while drilling that will be located at the predetermined muster points furthest upwind of the location of the H2S.

**F. PPE Available**

1. (10) 5 – minute escape packs will be installed on the rig floor for a quick escape.
2. (1) 10 – minute escape pack will be installed on the board.
3. (4) 30 – minutes SCBA's will be on-site. Two SCBA's will be placed at the entrance to the location (Muster Point #1) and the other two placed at Muster Point #2 on the other side of the location. This will allow either equipment to be in area that is upwind.

**Detection, Warning, and Monitoring Equipment**

1. (1) 4 – multichannel H2S Monitor with sensors placed on the floor, shakers, bell nipple and other to be placed where needed.
2. (2) hand held multi-gas monitor or a box of H2S tubes and a box of SO2 tubes to perform test in the event a monitor has been sounded.
3. (2) Safety Area Signs
4. (1) Condition Sign
5. (2) Wind socks that are to be placed in areas that can be seen at all times on the rig and at an height with good wind flow.


**Received**  
**Office of Oil & Gas**  
**JUN 15 2015**

10303130

## 7. Flaring

### A. Well Flaring

1. No flaring is anticipated on this well and therefore no flare lines will be utilized. Based on offset well information no significant gas flows should be encountered during drilling. If a significant show is encountered the gas would be flared through the 7" flanged flowline. This flowline will be anchored to the ground using chains and deadman stakes, and will be approximately 75 feet long.
2. In the unlikely event that gas needs to be flared. The well would be shut-in, and a smudge pot would be set up as a primary ignition with a marine flare pistol used as a backup igniter.
3. All flammable material within a minimum distance of 50' from the end of the flow line will be cleared, in case a flare would be needed.
4. The fire department will be notified immediately prior to flaring.
5. The duration of flaring typically will not last more than 7 days.
6. Schematic:

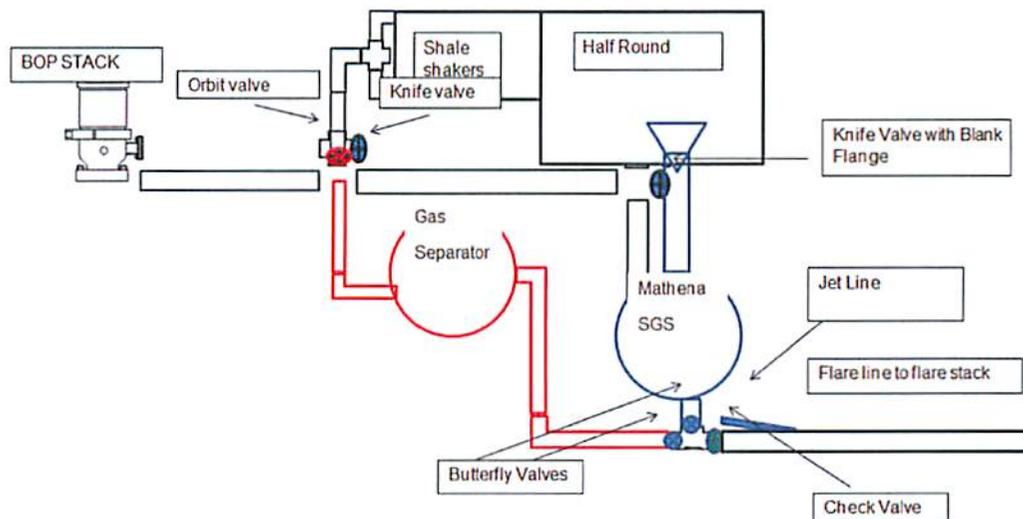

Received  
Office of Oil & Gas  
JUN 15 2015

**8. Collision Avoidance****Wellbore Anti-Collision and Directional Surveying****1. Survey Requirements**

- a. All wells shall be surveyed from the wellhead to a total depth using the guidelines specified in this document.
- b. Survey tool selection shall be based on the anti-collision requirements, survey tool accuracy, target size, and depth. Survey accuracy objectives shall be specified for each well in multiwell pad design.
- c. SWN preferred method of survey calculations shall be the Minimum Radius of Curvature method.
- d. All survey data shall be required to have azimuths pre-corrected to Grid North. The values for convergence and declinations and depth datum details used shall be reported on all definitive surveys. Additionally, survey tool accuracy should be specified on all surveys presented to SWN.
- e. During collision scans all offset well surveys will be evaluated for accuracy.

**1.1 General Requirements**

In all development wells, regularly spaced MWD or Magnetic Single Shot Surveys shall be taken at a frequency not to exceed 300'. During directional drilling the frequency shall be increased to every 90'. Additional surveys may be taken at the discretion of the directional driller, Drilling Representative, Drilling Superintendent, or Drilling Engineer.

*Additional multi-shot surveys shall be taken in the following circumstances:*

- 1.1.1 Gyro Single Shot Surveys shall be taken when drilling surface hole sections whenever magnetic interference is detected.
- 1.1.2 Gyro Multi Shot Surveys shall be taken to decrease positional uncertainty prior to drilling critical hole sections (i.e. high pressure sections, critical wellbore proximity hole sections, etc.). In this instance the requirements for the GMS shall be clearly stated in the drilling program.
- 1.1.3 In all pad drilling operations of multiple wells all surface casings will be surveyed with GMS before drilling that string.

Received  
Office of Oil & Gas  
November 15, 2015

## **1.2 Magnetic Survey Requirements**

- 1.2.1 MWD or Magnetic Single Shot (MSS) Surveys shall be taken at intervals of not more than 300' in vertical wells and at intervals of not more than 180' in tangent sections of deviated wells and at intervals of not more than 90' during build, turn, or drop sections.
- 1.2.2 The directional drilling contractor will calculate the following before each BHA is run:
  - a. Sufficient non-magnetic spacing is in place at both MWD and MMS positions to deliver < 1 degree azimuth error due to drill string interference.
  - b. BHA SAG correction for MWD and MMS positions. If SAG corrections is  $\geq 0.1$  degree inclination it must be applied.

## **1.3 Gyro Survey Requirements**

- 1.3.1 Gyro Multi-Shot (GMS) surveys shall be run in all surface and in intermediate casing strings for wells with S.F. < 2.0 on pad drilling projects.
- 1.3.2 Gyro Single Shot (GSS) shall be used in place of magnetic survey instruments in all cases where magnetic interference from nearby wells is experienced until separations from existing wells exceeds 30', or at any time when magnetic interference from other wells is suspected.

## **1.4 Survey Quality Control and Reporting**

- 1.4.1 Deviation calculations shall be performed on the rig independently by the directional driller and the Drilling Representative using the minimum radius of curvature method. The calculations shall be performed using a company approved program. The directional drilling contractor is responsible for the accurate reporting of all wellbore positioning data. The directional drilling contractor will present the definitive surveys utilizing data from any of SWN's surveying contractors.
- 1.4.2 The quality of the surveys taken shall be checked independently by the directional driller using the surveying contractor's approved survey acceptance criteria. For Gyro surveys this required a review and approval of the Gyro contractor's QA sheet. For MWD surveys this requires a review of the QA data sheet and a comparison to any MMS surveys.
- 1.4.3 The SWN representative will check tie-in data before drilling out of each hole section. Projected surveys will never be used to tie-in subsequent surveys.

Received  
Office of Oil & Gas  
JUN 15 2015

- 1.4.4 The Drilling Engineer and directional drilling contractor will ensure all directional drilling proposals include the correct tie-in data and clearly identify the projection to which the plan is tied. This projection will be replaced with a survey once drilling commences.
- 1.4.5 All definitive surveys will contain the following data:
- a. Well Name
  - b. Rig Floor Elevation
  - c. Local Coordinates
  - d. Section Plane
  - e. Declination Applied
  - f. Grid Convergence Applied
  - g. Any other correction applied
  - h. UTM Model
  - i. Survey History – Depths and Dates
  - j. Survey Tool Errors

## **2. Well Planning Requirements**

### *2.1 General Requirements*

- 2.1.1 No two wellbores should be designed to be closer than 10' once drilling commences. In the event that two surface locations are closer than 10' apart then directional equipment will be required below conductor and greater than 10' of separation shall be achieved as soon as possible.
- 2.1.2 During evaluation of well planning scenarios under the guidance of this policy, a situation may arise where a planning classification conflict occurs. In these situations the drilling department has the responsibility for safe operations and is therefore the ultimate decision making authority on all well classifications.
- 2.1.3 The Directional Drilling Contractor and Drilling Engineer shall make all efforts to plan well to avoid classification conflicts.
- 2.1.4 During the well planning process, the Directional Drilling Contractor and the Drilling Engineer shall calculate a Separation Factor for all potential collision risk wells identified in the clearance scan.
- 2.1.5 All wells planned with a S.F. of less than 2.0 or at any point closer than 10' planned center to center separation will be reviewed with the Drilling Engineering Manager prior to pre-spud meetings.

Received  
Office of Oil & Gas  
MAY 15 2015

- 2.1.6 After completion of location and prior to setting the conductor the land survey company will resurvey the stakes for each surface location and drive a steel stake in the ground identifying each individual well. An as-built will be created and circulated to the Drilling Engineer and Drilling Superintendent identifying each well and the appropriate X and Y locations.
- 2.1.7 The Drilling Superintendant will create a bubble plot of the location to indicate well location to compare to the As-Built Survey Plat.

## 2.2 Well Planning Process

- 2.2.1 A clearance scan shall be performed and validated for all well plans between the Drilling Engineer and Directional Contractor.
- 2.2.2 Every nearby well will be classified using the Planning Matrix (Appendix J).
- 2.2.3 Using the chosen well plan scenario and calculated Separation Factors, the potential collision risk will be categorized as one of these types:

4	Intolerable - Undrillable well.
3	Manageable Risk - High priority evaluation risk
2	Reasonable Risk - Evaluate and monitor
1	Negligible Risk - No further action required

- This compilation of scenarios was developed to address the majority of situations that could arise give the current types of well currently being drilled. In the future, if a different collision situation develops due to operational or area changes then this matrix will require modification (Appendix L).
- Well Category Definitions
  - a. Category 4 – Undrillable well  
Wells classified into this category present an unacceptable risk to personnel and/or facilities. Wells classified as 4 must be re-planned to an acceptable risk category.
  - b. Category 3 – Manageable Risk  
Wells classified into this category are deemed undrillable based on the presence of physical mitigation

(barriers below collision point, improved directional control/monitoring, etc.). Wells classified in this category during planning operations must be approved by the Drilling Engineering Manager.

- c. **Category 2 – Reasonable Risk**  
Well classified into this category are deemed drillable with lower risk of collision. All physical mitigation should be considered during planning.
- d. **Category 1 – Negligible Risk**  
This category is used for wells that require no additional actions as they are currently planned.

### 3. Well Execution Requirements

#### 3.1 General Requirements

- 3.1.1 The Drilling Representative shall have overall responsibility for the maintenance of safe operations when drilling in close proximity to other wells. The lead directional driller is responsible for the accurate reporting of the wellbore positioning and projection and calculation of bit position and uncertainty at the bit (Appendix A-I and L).

#### 3.2 Suspension of Drilling Operations

The following rules shall apply at all times when the calculated Separation Factor for the drilling well crosses either into a Category 4 classification or exceeds the Separation Factor specified in the wellplan.

- 3.1.1 When the classification of any collision risk well is Category 4 or the Separation Factor exceeds that specified in the wellplan, the Drilling Superintendent shall be informed and drilling shall immediately cease.
- 3.1.2 A plan of action shall be formulated after considering the following options:
  - a. Re-survey the current well with a more accurate survey tool to reduce the radius of uncertainty and increase the projected S.F. to return the well to Category 3 or that specified by the wellplan.
  - b. Make a trip to allow use of a steering BHA to alter the well path and increase the projection of S.F. to Category 3 or that specified by the wellplan.

Approved  
Office of Oil & Gas  
June 2015

- c. Plug the well and side-track at a depth where the well can be safely re-drilled.

**4. Drilling and Survey Procedure Guidelines**

The following guidelines and procedures detail the typical responses to be enacted in the event of drilling with close proximity to existing wells.

**3.1 General Guidelines for Drilling with Proximity to Other Wells**

The following guidelines should be considered prior to commencement of drilling collision-critical hole sections. A collision-critical hole section shall be defined as any interval of the drilling well requiring a form of mitigation to either detect or avoid a collision (Appendix M).

- 4.1.1 Magnetic based surveying instruments shall not be used as the prime source of well location identification within 20' of any collision risk well. When magnetic interference is suspected, gyro surveys should be run. Once free of magnetic interference, gyro surveys are unnecessary.
- 4.1.2 When doubt exists as to the accuracy of magnetic based survey information, these shall be checked with a gyro based tool before drilling ahead.
- 4.1.3 Proximity calculations and projections shall be performed at regular intervals depending on the collision risk. A minimum frequency of twice daily is mandatory, however when drilling with a S.F. of less than 1.5, the frequency shall be increased to every stand drilled.

**4.2 Drilling Procedure**

- 4.2.1 Proximity calculations shall be routinely performed when drilling hole sections of Category 2 or Category 3 wells.
- 4.2.2 When well paths are identified as converging and the proximity scan indicates a S.F. of less than stated in the drilling plan, the following procedure shall be applied:
  - a. The last survey station shall be calculated, plotted, and agreed by the directional driller and Drilling Representative.
  - b. The last survey station shall be extrapolated to depth corresponding to the bit position after drilling the next single.
  - c. An appropriate S.F. factor will be calculated using the projection of the next single.

- 4.2.3 Depending on the results of the proximity scan, the Drilling Representative shall enact the provisions of the policy per Section 3.4 if required.

Received  
Office of Oil & Gas  
JUN 15 2015

10303130

4.2.4 Re-instatement of collision risk wells and stand down from the anti-collision procedures above shall only be performed when the S.F. is restored to the planned values for the depth or the current well is below the deepest collision issue.

#### 4.3 *Tool Face Offset Procedure*

The On Site Supervisor may elect to utilize some or all of this procedure based on the confidence of third party personnel and criticality of drilling orientation (Appendix N).

4.1.1 If there are two directional drillers on location, both are to be on the drill floor when assembling the BHA.

4.1.2 Make up BHA and torque all connection's between the motor and MWD to recommended make up values.

4.1.3 Adjust motor AKO to needed bend and torque to recommended make up values.

4.1.4 Directional Driller will scribe motor/MWD as per Directional Companies guidelines.

4.1.5 MWD engineer imputes calculated value into MWD surface computer. Directional Driller will double check value was correctly placed in the computer.

4.1.6 The Directional Driller(s) and MWD operator should both be involved in measuring and calculating the tool face offset and double-checking each other while obtaining the correct value.

Received  
Office of Oil & Gas  
JUN 15 2015

10303130

**Appendix A – Field Specific Requirements for SIMOPS:  
Drilling in addition to Completion &/or Production Operation(s)**

		Fayetteville	Haynesville	Barnett	Marcellus	Eagle Ford
<b>Common Well Spacing</b>		Various	20'	15'	14'	20'
<b>Under Substructure</b>	<b>SI for MIRU / RDMO</b>	Yes - All Wells				
	<b>Production Allowed</b>	No				
	<b>Cage</b>	Depends - If Warranted				
	<b>Subsurface Mech Barrier</b>	Yes - All Capable Wells				
	<b>Surface Mech Barriers</b>	Yes - All Wells				
	<b>Remove WH</b>	Depends - If Warranted				
	<b>Collision Barriers</b>	Depends - If Warranted				
	<b>Completion Operation(s) Allowed</b>	No - Not Possible				
	<b>Other Considerations</b>	Requires VP approval to circumvent policy				
<b>Separation Factor &lt; 2.0</b>	<b>SI for MIRU / RDMO</b>	Yes - All Wells				
	<b>Production Allowed</b>	Only wells (and affiliated pressurized equipment) that are located <u>outside</u> the rig fall radius, not required to have a Subsurface Mechanical Barrier per Anti-Collision requirements and <u>not adjacent</u> to Mob and Demob routes.				
	<b>Cage</b>	Yes - All Capable Wells located <u>inside</u> the rig fall radius				
	<b>Subsurface Mech Barrier</b>	Yes - All Capable Wells located <u>inside</u> the rig fall radius and those required by Anti-Collision requirements				
	<b>Surface Mech Barriers</b>	Yes - All Wells located <u>inside</u> the rig fall radius or <u>adjacent</u> to Mob and Demob routes				
	<b>Remove WH</b>	No				
	<b>Collision Barriers</b>	Yes - All Capable Wells and equipment located <u>inside</u> the rig fall radius or <u>adjacent</u> to Mob and Demob Routes				
	<b>Completion Operation(s) Allowed</b>	No				
	<b>Other Considerations</b>	Requires VP approval to circumvent policy				
<b>Separation Factor &gt; 2.0</b>	<b>SI for MIRU / RDMO</b>	Yes - All Wells				
	<b>Production Allowed</b>	Only wells (and affiliated pressurized equipment) that are located <u>outside</u> the rig fall radius, not required to have a Subsurface Mechanical Barrier per Anti-Collision requirements and <u>not adjacent</u> to Mob and Demob routes.				
	<b>Cage</b>	Yes - All Capable Wells located <u>inside</u> the rig fall radius				
	<b>Subsurface Mech Barrier</b>	Yes - All Capable Wells located <u>inside</u> the rig fall radius and those required by Anti-Collision requirements				
	<b>Surface Mech Barriers</b>	Yes - All Wells located <u>inside</u> the rig fall radius or <u>adjacent</u> to Mob and Demob routes				
	<b>Remove WH</b>	No				
	<b>Collision Barriers</b>	Yes - All Capable Wells and equipment located <u>inside</u> the rig fall radius or <u>adjacent</u> to Mob and Demob Routes				
	<b>Completion Operation(s) Allowed</b>	No				
	<b>Other Considerations</b>	Requires DM approval to circumvent policy				
<b>PIC</b>		Drilling Representative				


Received  
Office of Oil & Gas  
JUN 15 2015

10303130

Appendix B – Field Specific Requirements for SIMOPS:  
More than one Completion and/or Production Operation(s)

		Fayetteville	Haynesville	Barnett	Marcellus	Eagle Ford
Common Well Spacing		Various	20'	15'	14'	20'
Stimulation	SI for MIRU / RDMO	Yes - All Wells				
	Cage	Yes, if wells are Capable and adjacent to Mob & Demob Routes or within Potential Impact Area of Heavy Lifts				
	Subsurface Mech Barrier	No				
	Surface Mech Barriers	Yes, if wells are Capable and adjacent to Mob & Demob Routes or within Potential Impact Area of Heavy Lifts				
	Remove WH	No				
	Collison Barrier	Yes, Mob & Demob Routes				
	Production Allowed	Yes, if wells <u>are not</u> adjacent to Mob & Demob Routes and / or within Potential Impact Area of Heavy Lifts. Must consider if wells could be impacted by stimulation				
Workover Rig and Coiled Tubing	SI for MIRU / RDMO	Yes - All Wells				
	Cage	Yes, if wells are Capable and adjacent to Mob & Demob Routes or within Potential Impact Area of Heavy Lifts				
	Subsurface Mech Barrier	No				
	Surface Mech Barriers	Yes, if wells are Capable and adjacent to Mob & Demob Routes or within Potential Impact Area of Heavy Lifts				
	Remove WH	No				
	Collision Barrier	Depends - Yes, Mob & Demob Routes when numerous vehicles and/or significant amounts of transported equipment will be involved				
	Production Allowed	Yes, if wells are outside the rig fall radius, <u>are not</u> adjacent to Mob & Demob Routes or within Potential Impact Area of Heavy Lifts.				
Slickline and Wireline	SI for MIRU / RDMO	Yes, if wells are Capable and within Potential Impact Area of Heavy Lifts				
	Cage	Yes, if wells are Capable and within Potential Impact Area of Heavy Lifts				
	Subsurface Mech Barrier	No				
	Surface Mech Barriers	Yes, if wells are Capable and within Potential Impact Area of Heavy Lifts				
	Remove WH	No				
	Collision Barrier	No				
	Production Allowed	Yes, if wells <u>are not</u> within Potential Impact Area of Heavy Lifts				
PIC - When Completions Department is involved		Completion Representative				
PIC - Otherwise		Production Representative				

Received  
Office of Oil & Gas  
JUN 15 2015

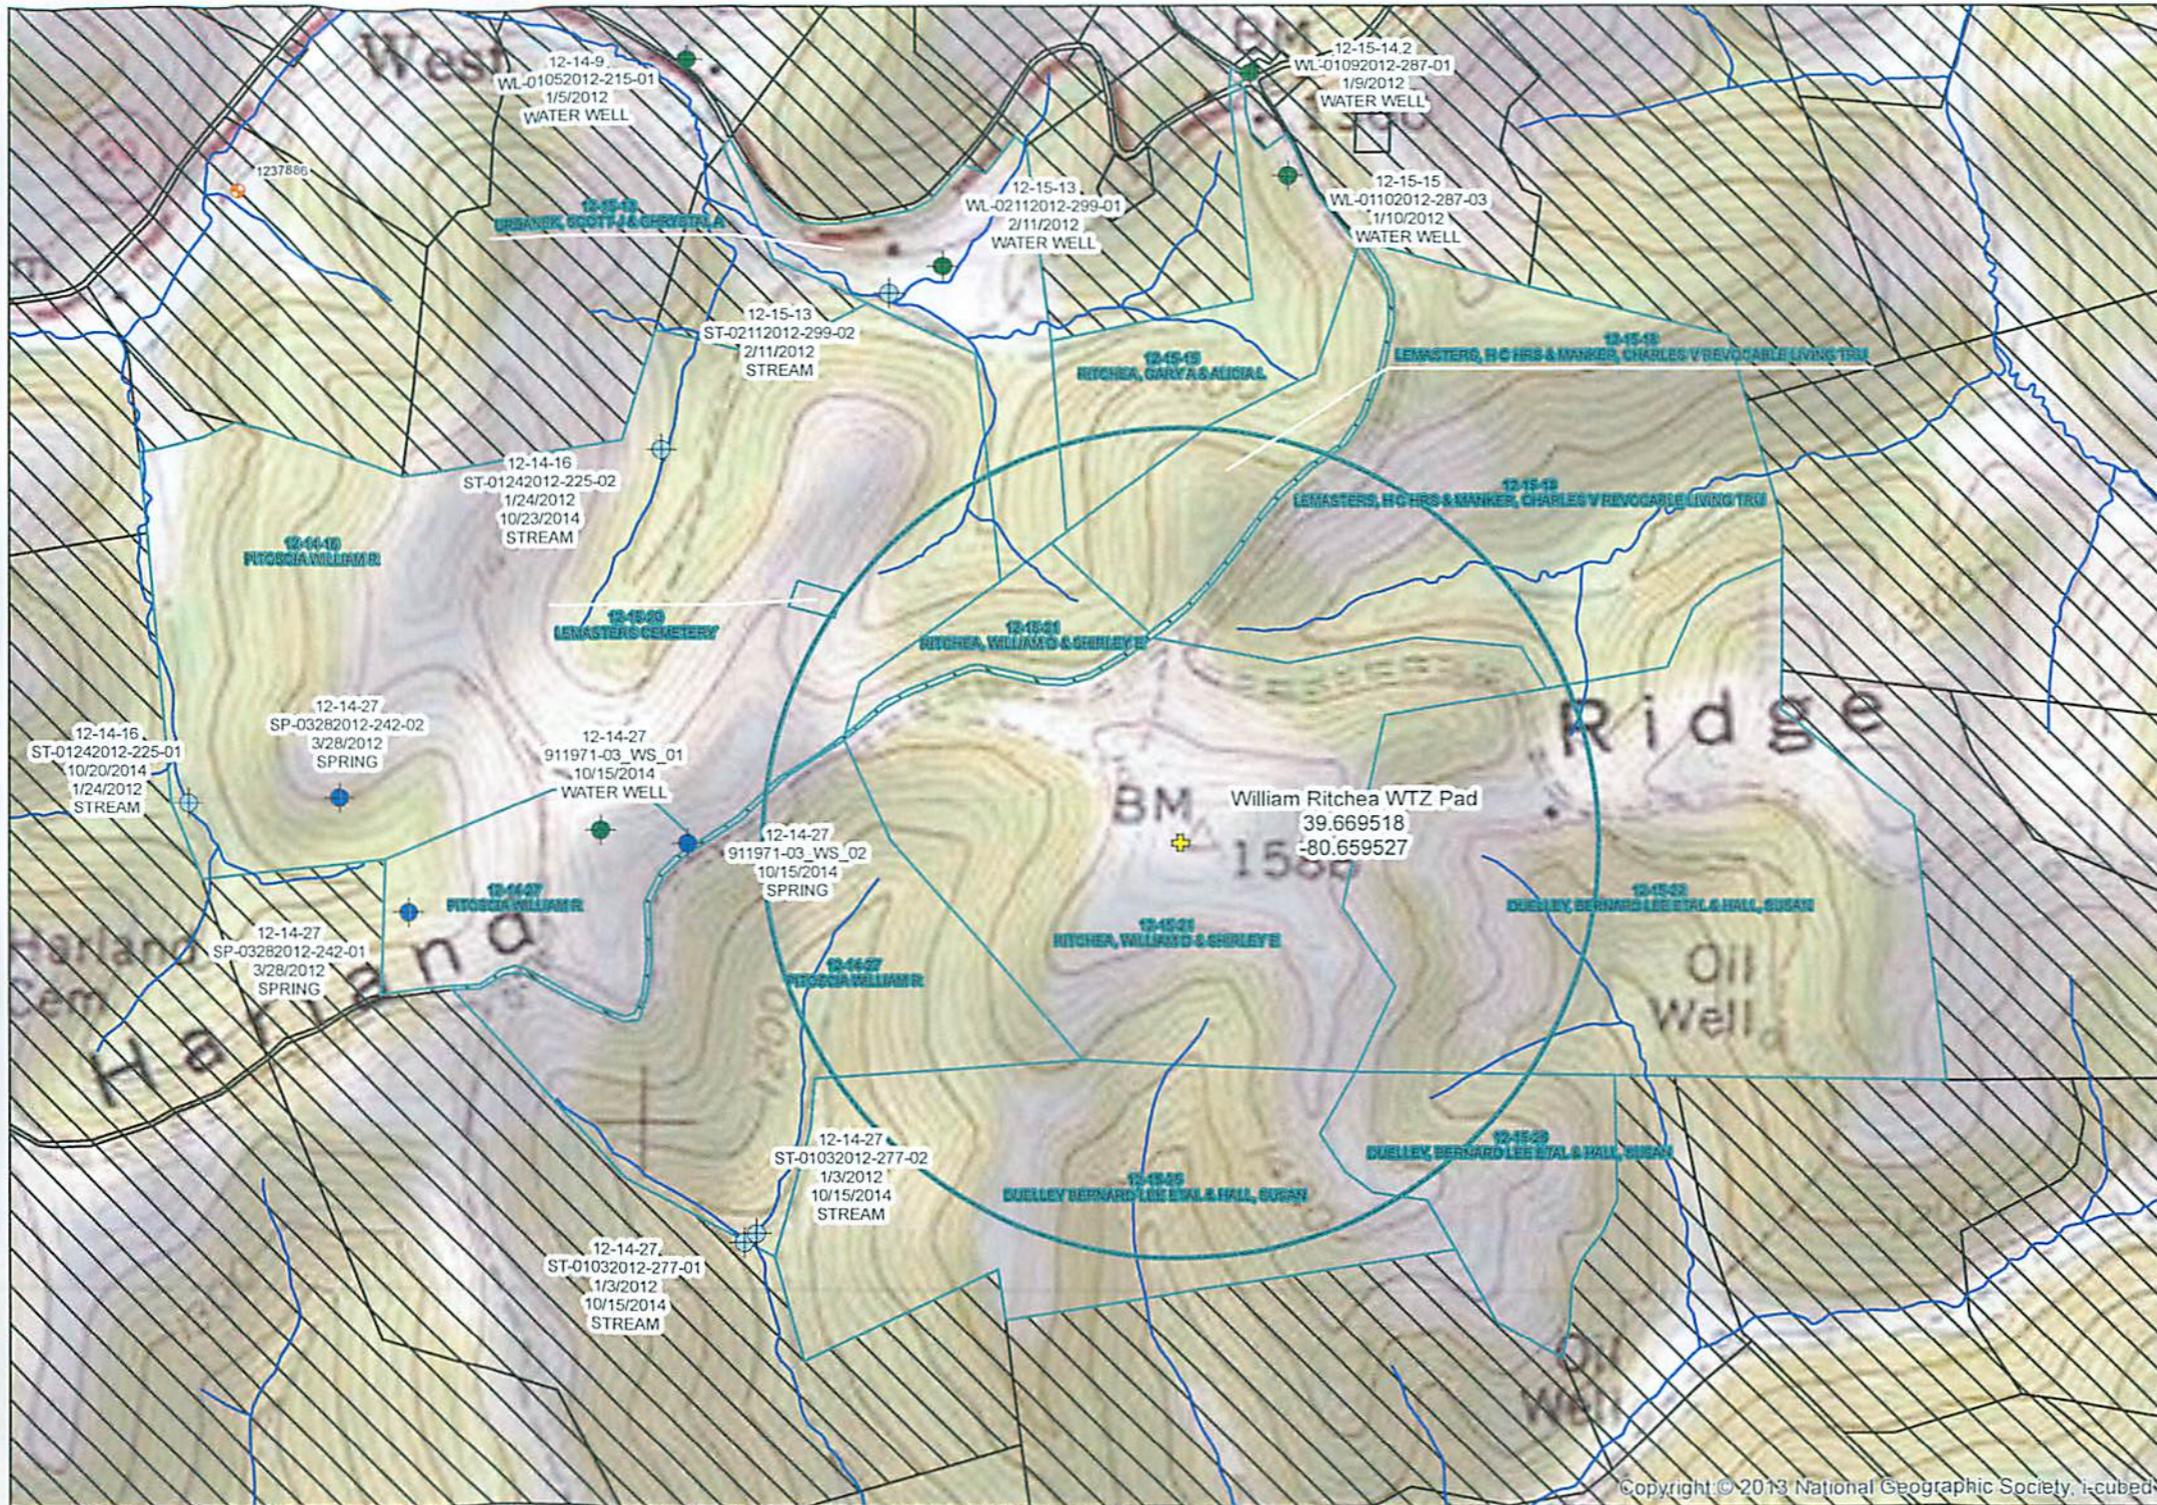

**Legend**

- William Ritchea WTZ Pad
- USGS NURE Well
- Streams
- 1,500' Radius of Site
- Parcel Outside the Radius
- Parcel Within 1,500' of Site - 10 parcels highlighted

**Baseline Sample Location**

- Spring
- Water Well
- Stream

Baseline Sample Location labeled with:  
 Parcel Number  
 System Location Code  
 Sample Date  
 Location Type



William Ritchea WTZ Pad  
 39.669518  
 -80.659527

Map Coordinate System:  
 NAD 1983 StatePlane West Virginia North FIPS 470  
 Projection: Lambert Conformal Conic  
 Datum: North American 1983  
 False Easting: 1,968,500.0000

Notes:  
 1. SWN is abbreviation for SWN Production Company, LLC  
 2. The stream and surface water data were obtained from <http://wvgis.wvu.edu/data/dataset.php?ID=265>

0 350 700 1,400 Feet

1 inch = 700 feet

**SWN Production Company, LLC**  
 William Ritchea WTZ Pad  
 Wetzel County, WV

**Permit Map**

drawn: TAY	checked:	approved:	figure no.:
date: 06/09/2015	date:	date:	1
job no. 313738.00.0000.1000.0100	file no. William_Ritchea_Permittng		
initials	date	revision	

**leidos**



320 O'Bryan Lane • Van Buren, AR 72956  
Office: 479.474.7916 • Fax: 479.474.2450  
Surveying • handa-inc.com

LINE	DESCRIPTION	DISTANCE	DESCRIPTION	MONUMENT
L1	N 73°23'43" W	1293.15'	SHL TO LANDMARK	5/8" REBAR
L2	S 46°17'43" W	837.31'	SHL TO LANDMARK	5/8" REBAR
L3	S 56°44'28" W	1891.25'	SHL TO TPL	
L4	N 45°00'02" W	6882.62'	TPL TO BHL	
L5	N 68°55'54" E	323.47'	SHL TO REF. PNT.	5/8" REBAR
L6	S 62°37'48" W	215.31'	SHL TO REF. PNT.	5/8" REBAR

Latitude: 39°42'30"

Longitude: 80°37'30"

TRACT	SURFACE OWNER (S) / ROYALTY OWNER (R)	TAX PARCEL	ACRES	LEASE NUMBER
2	WILLIAM D RITCHEA & SHIRLEY E RITCHEA (S/R)	12-15-21	62.00	WV-0000113-000
3	WILLIAM R PITOSCIA (S) TASA CORPORATION (R) HERBERT W LINDSAY & MARIE LINDSAY (R) RUSSELL RAND & GWENDOLYN RAND (R)	12-14-27	57.00	WV-0000109-001 WV-0000109-002 WV-0000109-003
1	BERNARD LEE DUELLEY ETAL & SUSAN HALL (S) SARAH J TAYLOR & FRIEND TAYLOR, C T LEMASTERS & LILLI LEMASTERS, L L LEMASTERS & MARION J LEMASTERS, WESLEY S SMITH & ALMA SMITH, JESSE SMITH & IRENE SMITH, LEONA RITER, VIRGINIA SMITH & HAROLD SMITH (R) GARNET SNIDER & HUGH SNIDER (R) HAROLD EUGENE LEMASTERS & BETTY LEE LEMASTERS (R) VIRGINIA M BALLARD & ANGLD C BALLARD & PAUL R LEMASTERS (R) OLIVE SAPP (R) ALMA SMITH (R) TRIO PETROLEUM CORP & WACO OIL & GAS CO (R) TED ARNOLD NEELY (R) MARGUERITE SOBUTKA (R) JOHN A. NEELY AND SHIRLEY M. NEELY (R) JOSEPHINE M. SMITH AND LINDA L. BARNES (R) AMY ROSALIE NOAH AND LONNIE M. NOAH (R) WILLIAM MICHAEL NEELY (R) EDITH V ROMACK (R) WILLIAM A SMITH & LUCILLE M SMITH (R)	12-15-25	4.00	WV-0000110-000 WV-0000111-003 WV-0000111-014 WV-0000111-001 WV-0000111-002 WV-0000111-005 WV-0000111-013 WV-0000111-011 WV-0000111-006 WV-0000111-009 WV-0000111-007 WV-0000111-010 WV-0000111-012 WV-0000111-004 WV-0000111-008

TRACT	SURFACE OWNER (S) / ROYALTY OWNER (R)	TAX PARCEL	ACRES	LEASE NUMBER
4	WILLIAM R PITOSCIA (S) TASA CORPORATION (R) HERBERT W LINDSAY & MARIE LINDSAY (R) RUSSELL RAND & GWENDOLYN RAND (R)	12-14-16	104.01	WV-0000109-001 WV-0000109-002 WV-0000109-003
5	MICHAEL E LASURE & VELVA C LASURE (S/R)	12-14-14	25.00	WV-0000184-001
6	MICHAEL E LASURE & VELVA C LASURE (S) RAY C HERMAN & ROSE M HERMAN & DAL A HERMAN (R)	12-14-6	52.89	WV-0000128-000
7	RAY C HERMAN & DAL A HERMAN (R) RONNIE E WADE & YVORNE M WADE (S) HAROLD H BLAKE & DONNA M BLAKE (R)	12-14-4.1	94.37	1-254831-000 WV-0000150-001
8	NORMAN E KEENEY JR & NANCY M KEENEY (S) OTIS SIMMONS & MABEL SIMMONS, ETHEL RAMSEY & ELMER RAMSEY, & HAROLD SIMMONS & ROXIE SIMMONS (R)	12-9-45	100.00	1-254812-000

NOTES ON SURVEY

- COORDINATES SYSTEM IS UTM, NAD 83 DATUM, ZONE 17, U.S. FOOT AND WELL COORDINATES ESTABLISHED USING SURVEY GRADE GPS.
- SURFACE AND ROYALTY OWNER INFORMATION AND THEIR BOUNDARIES SHOWN HEREON WERE PLOTTED FROM DEEDS AND/OR TAX PARCEL MAPS PROVIDED BY CLIENT AND FIELD LOCATIONS.
- THIS PLAT DOES NOT REPRESENT A BOUNDARY SURVEY OF THE PARCELS SHOWN HEREON.
- NO DWELLINGS AND BUILDINGS WITHIN 625 FEET OF PROPOSED OF CENTER OF PAD.
- NO WATER WELLS OR DEVELOPED SPRINGS WITHIN 250 FEET OF PROPOSED WELL.
- NO PERENNIAL STREAMS, LAKES, PONDS, RESERVOIRS OR WETLANDS WITHIN 1000 FEET OF THE LIMITS OF DISTURBANCE.
- NO NATURALLY PRODUCING TROUT STREAM WITHIN 300 FEET OF LIMITS OF DISTURBANCE.

SURFACE HOLE LOCATION (SHL):

GEOGRAPHIC (NAD83):  
LATITUDE: 39.669606'  
LONGITUDE: -80.659437'

UTM (NAD83, ZONE 17, FEET):  
NORTHING: 14,406,608.961  
EASTING: 1,736,249.851

UTM (NAD83, ZONE 17, METERS):  
NORTHING: 4,391,143.194  
EASTING: 529,210.013

"TURNING POINT" LOCATION (TPL):

GEOGRAPHIC (NAD83):  
LATITUDE: 39.666775'  
LONGITUDE: -80.665068'

UTM (NAD83, ZONE 17, FEET):  
NORTHING: 14,405,572.234  
EASTING: 1,734,669.120




UTM (NAD83, ZONE 17, METERS):  
NORTHING: 4,390,827.198  
EASTING: 528,728.205

BOTTOM HOLE LOCATION (BHL):


GEOGRAPHIC (NAD83):  
LATITUDE: 39.880183'  
LONGITUDE: -80.682293'

UTM (NAD83, ZONE 17, FEET):  
NORTHING: 14,410,436.663  
EASTING: 1,729,804.578

UTM (NAD83, ZONE 17, METERS):  
NORTHING: 4,392,309.880  
EASTING: 527,245.490

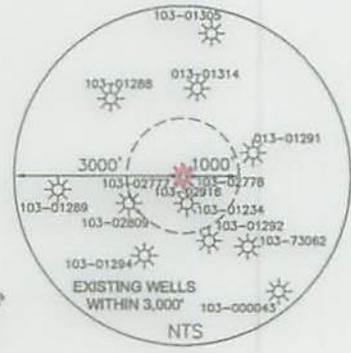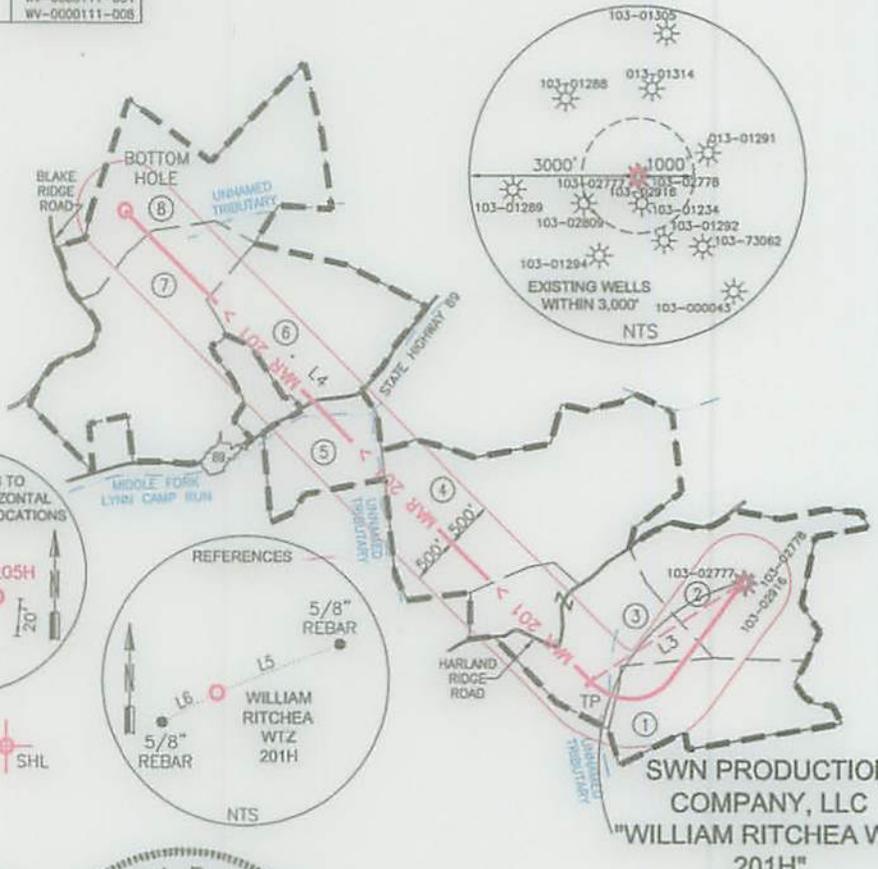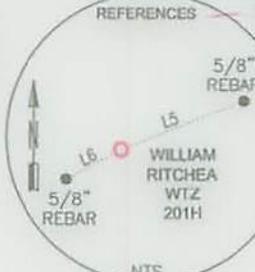

SURVEYED BY TRIPLE H ENTERPRISES, WEST UNION, WV.

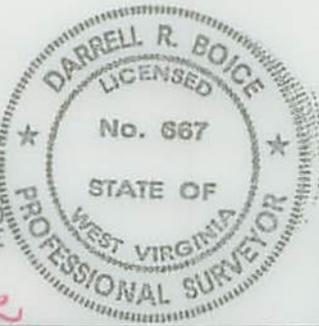

I, THE UNDERSIGNED, HEREBY CERTIFY THAT THIS PLAT IS CORRECT TO THE BEST OF MY KNOWLEDGE AND BELIEF AND SHOWS ALL THE INFORMATION REQUIRED BY LAW AND REGULATIONS ISSUED AND PRESCRIBED BY THE DEPARTMENT OF ENVIRONMENTAL PROTECTION.

P.S. 667 *Darrell R. Boice*

(+) DENOTES LOCATION OF WELL ON UNITED STATES TOPOGRAPHIC MAPS WVDEP OFFICE OF OIL & GAS 601 57TH STREET CHARLESTON, WV 25034	MINIMUM DEGREE OF ACCURACY: 1/200 PROVEN SOURCE OF ELEVATION: SURVEY GRADE GPS (NAVD 88, US FT)	COMPANY: SWN Production Company, LLC WILLIAM RITCHEA WTZ 201H OPERATOR'S WELL #: 201H API WELL #: 47 STATE, 103 COUNTY, 03130 HGA PERMIT
---	--	---

WELL TYPE: OIL  WASTE DISPOSAL  PRODUCTION  DEEP  GAS  LIQUID INJECTION  STORAGE  SHALLOW

WATERSHED: LITTLE FISHING CREEK ELEVATION: 1563.2'

DISTRICT: PROCTOR COUNTY: WETZEL QUADRANGLE: WILEYVILLE, WV

SURFACE OWNER: WILLIAM D & SHIRLEY E RITCHEA ACREAGE: ±62.00

OIL & GAS ROYALTY OWNER: WILLIAM D & SHIRLEY E RITCHEA ACREAGE: ±62.00

DRILL  DRILL DEEPER  REDRILL  FRACTURE OR STIMULATE  PLUG OFF OLD FORMATION  PERFORATE NEW FORMATION

CONVERT  PLUG & ABANDON  CLEAN OUT & REPLUG  OTHER CHANGE  (SPECIFY)

TARGET FORMATION: MARCELLUS ESTIMATED DEPTH: 7,556 TVD 16,243 TMD

WELL OPERATOR: SWN PRODUCTION COMPANY, LLC DESIGNATED AGENT: DEE SOUTHALL

ADDRESS: P.O. BOX 1300 ADDRESS: P.O. BOX 1300

CITY: JANE LEW STATE: WV ZIP CODE: 26378 CITY: JANE LEW STATE: WV ZIP CODE: 26378

<b>LEGEND:</b> ○ PROPOSED SURFACE HOLE / BOTTOM HOLE * EXISTING / PRODUCING WELLHEAD X ABANDONED WELL ⊕ PLUGGED & ABANDONED WELL △ CUT CONDUCTOR --- LEASE BOUNDARY --- 500' DHP BUFFER --- MAR 1 > --- MARCELLUS DHP --- ABANDONED PATH	<b>REVISIONS:</b> DATE: 05-14-2015 DRAWN BY: S. HUTSON SCALE: 1" = 2000' DRAWING NO: 58715 WELL LOCATION PLAT
---	--

10303130

WW-6A1  
(5/13)

Operator's Well No. William Ritchie WIZ 2014

**INFORMATION SUPPLIED UNDER WEST VIRGINIA CODE  
Chapter 22, Article 6A, Section 5(a)(5)  
IN LIEU OF FILING LEASE(S) AND OTHER CONTINUING CONTRACT(S)**

Under the oath required to make the verification on page 1 of this Notice and Application, I depose and say that I am the person who signed the Notice and Application for the Applicant, and that –

- (1) the tract of land is the same tract described in this Application, partly or wholly depicted in the accompanying plat, and described in the Construction and Reclamation Plan;
- (2) the parties and recordation data (if recorded) for lease(s) or other continuing contract(s) by which the Applicant claims the right to extract, produce or market the oil or gas are as follows:

Lease Name or Number	Grantor, Lessor, etc.	Grantee, Lessee, etc.	Royalty	Book/Page
----------------------	-----------------------	-----------------------	---------	-----------

SEE EXHIBIT

**Acknowledgement of Possible Permitting/Approval  
In Addition to the Office of Oil and Gas**

The permit applicant for the proposed well work addressed in this application hereby acknowledges the possibility of the need for permits and/or approvals from local, state, or federal entities in addition to the DEP, Office of Oil and Gas, including but not limited to the following:

- WV Division of Water and Waste Management
- WV Division of Natural Resources WV Division of Highways
- U.S. Army Corps of Engineers
- U.S. Fish and Wildlife Service
- County Floodplain Coordinator

Received  
Office of Oil & Gas

The applicant further acknowledges that any Office of Oil and Gas permit in no way overrides, replaces, or nullifies the need for other permits/approvals that may be necessary and further affirms that all needed permits/approvals should be acquired from the appropriate authority before the affected activity is initiated.

Well Operator: SWN Production Company, LLC.  
 By: Caleb Weaver   
 Its: Landman

EXHIBIT "A"

Attached to and made a part of the State of West Virginia Oil and Gas Permit Form, WW-6A1, by SWN Production Company, L.L.C., Operator  
 Ritchea North 201H  
 Wetzel County, West Virginia

#	TMP	LEASE #	LESSOR	LESSEE	ROYALTY	BK/PG
8	<u>12-0009-0045-0000</u>	1-254812-000	Otis Simmons and Mabel Simmons, his wife, Ethel Ramsey and Elmer Ramsey, her husband, and Harold Simmons and Roxie Simmons, his wife	The Manufacturers Light and Heat Company Columbia Gas Transmission Corporation Chesapeake Appalachia, L.L.C. SWN Production Company, L.L.C.	12.50%	<u>52A/263</u> <u>84A/129</u> <u>90A/242</u> <u>157A/540</u>
7	<u>12-0014-0004-0001</u>	WV0000150-001	Harold H. Blake and Donna M. Blake, his wife	Haddad and Brooks, Inc. Chesapeake Appalachia, L.L.C. SWN Production Company, L.L.C.	12.50%	<u>82A/105</u> <u>104A/230</u> <u>157A/540</u>
6	<u>12-0014-0006-0000</u>	WV0000128-000	Ray C. Herman and Rose M. Herman, his wife, and Dail A. Herman, single	Mobay Chemical Corporation Haddad and Brooks, Inc. Chesapeake Appalachia, L.L.C. SWN Production Company, L.L.C.	12.50%	<u>60A/143</u> <u>65A/67</u> <u>120A/109</u> <u>157A/540</u>
6	<u>12-0014-0006-0000</u>	1-254831-000	Ray C. Herman and Dail A. Herman	The Manufacturers Light and Heat Company Columbia Gas Transmission Corporation Chesapeake Appalachia, L.L.C. SWN Production Company, L.L.C.	12.50%	<u>45A/314</u> <u>84A/129</u> <u>90A/242</u> <u>157A/540</u>
5	<u>12-0014-0014-0000</u>	WV0000164-001	Michael E. Lasure and Velva C. Lasure, husband and wife	Haddad and Brooks, Inc. Chesapeake Appalachia, L.L.C. SWN Production Company, L.L.C.	12.50%	<u>79A/192</u> <u>104A/230</u> <u>157A/540</u>

103-03/30

EXHIBIT "A"

Attached to and made a part of the State of West Virginia Oil and Gas Permit Form, WW-6A1, by SWN Production Company, L.L.C., Operator  
 Ritchea North 201H  
 Wetzel County, West Virginia

#	TMP	LEASE #	LESSOR	LESSEE	ROYALTY	BK/PG
4	<u>12-0014-0016-0000</u>	WV0000109-001	TASA Corporation, formerly TASA Coal Company	J&J Enterprises, formerly TASA Coal Company Chesapeake Appalachia, L.L.C. SWN Production Company, L.L.C.	12.50%	<u>65A/313</u> <u>103A/350</u> <u>157A/540</u>
4	<u>12-0014-0016-0000</u>	WV0000109-002	Herbert W. Lindsay and Marie Lindsay, husband and wife	Haddad and Brooks, Inc. Chesapeake Appalachia, L.L.C. SWN Production Company, L.L.C.	12.50%	<u>64A/423</u> <u>102A/302</u> <u>157A/540</u>
4	<u>12-0014-0016-0000</u>	WV0000109-003	Russell Rand and Gwendolyn Rand, husband and wife	Haddad and Brooks, Inc. Chesapeake Appalachia, L.L.C. SWN Production Company, L.L.C.	12.50%	<u>64A/425</u> <u>103A/302</u> <u>157A/540</u>
3	<u>12-0014-0027-0000</u>	WV0000109-001	TASA Corporation, formerly TASA Coal Company	J&J Enterprises, formerly TASA Coal Company Chesapeake Appalachia, L.L.C. SWN Production Company, L.L.C.	12.50%	<u>65A/313</u> <u>103A/350</u> <u>157A/540</u>
3	<u>12-0014-0027-0000</u>	WV0000109-002	Herbert W. Lindsay and Marie Lindsay, husband and wife	Haddad and Brooks, Inc. Chesapeake Appalachia, L.L.C. SWN Production Company, L.L.C.	12.50%	<u>64A/423</u> <u>102A/302</u> <u>157A/540</u>

103-03130

**EXHIBIT "A"**

Attached to and made a part of the State of West Virginia Oil and Gas Permit Form, WW-6A1, by SWN Production Company, L.L.C., Operator  
 Ritchea North 201H  
 Wetzel County, West Virginia

#	TMP	LEASE #	LESSOR	LESSEE	ROYALTY	BK/Pg
3	<u>12-0014-0027-0000</u>	WV0000109-003	Russell Rand and Gwendolyn Rand, husband and wife	Haddad and Brooks, Inc. Chesapeake Appalachia, L.L.C. SWN Production Company, L.L.C.	12.50%	<u>64A/425</u> <u>103A/302</u> <u>157A/540</u>
2	<u>12-0015-0021-0000</u>	WV0000113-000	William D. Ritchea and Shirley E. Ritchea, husband and wife	Mobay Chemical Corporation Wescap Oil and Gas Company Haddad and Brooks, Inc. Chesapeake Appalachia, L.L.C. SWN Production Company, L.L.C.	12.50%	<u>60A/59</u> <u>63A/34</u> <u>66A/547</u> <u>102A/302</u> <u>157A/540</u>
1	<u>12-0015-0025-0000</u>	WV0000110-000	Sarah J. Taylor, Friend Taylor, her husband, C. T. Lemasters and Lulu Lemasters, his wife, L. L. Lemasters and Martha J. Lemasters, his wife, Wesley S. Smith and Alma Smith, his wife, Jesse Smith and Irene Smith, his wife, Leona Riter, Virginia Smith and her husband Harold Smith	J. D. Wade and E. Carney J. M. Coogle Charles and Caroline Coogle George F. Eagon Haddad and Brooks, Inc. Chesapeake Appalachia, L.L.C. SWN Production Company, L.L.C.	12.50%	<u>25A/337</u> <u>31A/281</u> <u>177/9</u> <u>40A/149</u> <u>65A/406</u> <u>102A/302</u> <u>157A/540</u>
1	<u>12-0015-0025-0000</u>	WV0000111-003	Garnet Snider and Hugh Snider, wife and husband	Haddad and Brooks, Inc. Chesapeake Appalachia, L.L.C. SWN Production Company, L.L.C.	12.50%	<u>72A/352</u> <u>102A/302</u> <u>157A/540</u>

103-03130

EXHIBIT "A"

Attached to and made a part of the State of West Virginia Oil and Gas Permit Form, WW-6A1, by SWN Production Company, L.L.C., Operator  
 Ritchea North 201H  
 Wetzel County, West Virginia

#	TMP	LEASE #	LESSOR	LESSEE	ROYALTY	BK/PG
1	<u>12-0015-0025-0000</u>	WV0000111-014	Harold Eugene Lemasters and Betty Lee Lemasters, his wife	Mobay Chemical Corporation Haddad and Brooks, Inc. Chesapeake Appalachia, L.L.C. SWN Production Company, L.L.C.	12.50%	<u>65A/52</u> <u>65A/67</u> <u>106A/970</u> <u>157A/540</u>
1	<u>12-0015-0025-0000</u>	WV0000111-001	Virginia M. Ballard and Anglo C. Ballard, wife and husband, and Paul R. Lemasters	Haddad and Brooks, Inc. Chesapeake Appalachia, L.L.C. SWN Production Company, L.L.C.	12.50%	<u>72A/324</u> <u>102A/302</u> <u>157A/540</u>
1	<u>12-0015-0025-0000</u>	WV0000111-002	Olive Sapp, a widow	Haddad and Brooks, Inc. Chesapeake Appalachia, L.L.C. SWN Production Company, L.L.C.	12.50%	<u>72A/348</u> <u>102A/302</u> <u>157A/540</u>
1	<u>12-0015-0025-0000</u>	WV0000111-005	Alma Smith, a widow	Haddad and Brooks, Inc. Chesapeake Appalachia, L.L.C. SWN Production Company, L.L.C.	12.50%	<u>72A/297</u> <u>102A/302</u> <u>157A/540</u>
1	<u>12-0015-0025-0000</u>	WV0000111-013	Trio Petroleum Corp. and Waco Oil & Gas Co.	Haddad and Brooks, Inc. Chesapeake Appalachia, L.L.C. SWN Production Company, L.L.C.	12.50%	<u>72A/299</u> <u>102A/302</u> <u>157A/540</u>

103-03130

EXHIBIT "A"

Attached to and made a part of the State of West Virginia Oil and Gas Permit Form, WW-6A1, by SWN Production Company, L.L.C., Operator  
 Ritchea North 201H  
 Wetzel County, West Virginia

#	TMP	LEASE #	LESSOR	LESSEE	ROYALTY	BK/PG
1	<u>12-0015-0025-0000</u>	WV0000111-011	Ted Arnold Neely	Haddad and Brooks, Inc. Chesapeake Appalachia, L.L.C. SWN Production Company, L.L.C.	12.50%	<u>72A/336</u> <u>102A/302</u> <u>157A/540</u>
1	<u>12-0015-0025-0000</u>	WV0000111-006	Marguerite Sobotka	Haddad and Brooks, Inc. Chesapeake Appalachia, L.L.C. SWN Production Company, L.L.C.	12.50%	<u>72A/354</u> <u>102A/302</u> <u>157A/540</u>
1	<u>12-0015-0025-0000</u>	WV0000111-009	John A. Neely and Shirley M. Neely	Haddad and Brooks, Inc. Chesapeake Appalachia, L.L.C. SWN Production Company, L.L.C.	12.50%	<u>72A/439</u> <u>102A/302</u> <u>157A/540</u>
1	<u>12-0015-0025-0000</u>	WV0000111-007	Josephine M. Smith and Linda L. Barnes	Haddad and Brooks, Inc. Chesapeake Appalachia, L.L.C. SWN Production Company, L.L.C.	12.50%	<u>72A/592</u> <u>106A/970</u> <u>157A/540</u>
1	<u>12-0015-0025-0000</u>	WV0000111-010	Amy Rosalie Noah and Lonnie M. Noah	Haddad and Brooks, Inc. Chesapeake Appalachia, L.L.C. SWN Production Company, L.L.C.	12.50%	<u>72A/584</u> <u>102A/302</u> <u>157A/540</u>

103-03120

**EXHIBIT "A"**

Attached to and made a part of the State of West Virginia Oil and Gas Permit Form, WW-6A1, by SWN Production Company, L.L.C., Operator  
 Ritchea North 201H  
 Wetzell County, West Virginia

#	TMP	LEASE #	LESSOR	LESSEE	ROYALTY	BK/PG
1	<u>12-0015-0025-0000</u>	WV0000111-012	William Michael Neely	Haddad and Brooks, Inc. Chesapeake Appalachia, L.L.C. SWN Production Company, L.L.C.	12.50%	<u>72A/637</u> <u>102A/302</u> <u>157A/540</u>
1	<u>12-0015-0025-0000</u>	WV0000111-004	Edith V. Romack, a widow	Haddad and Brooks, Inc. Chesapeake Appalachia, L.L.C. SWN Production Company, L.L.C.	12.50%	<u>72A/295</u> <u>102A/302</u> <u>157A/540</u>
1	<u>12-0015-0025-0000</u>	WV0000111-008	William A. Smith and Lucille M. Smith, husband and wife	Haddad and Brooks, Inc. Chesapeake Appalachia, L.L.C. SWN Production Company, L.L.C.	12.50%	<u>72A/350</u> <u>102A/302</u> <u>157A/540</u>

103-03130

10303130



May 29, 2015

Ms. Laura Adkins  
WV DEP Office of Oil & Gas  
601 57<sup>th</sup> St., SE  
Charleston, WV 25304

**RE:** SWN's proposed William Ritchea WTZ 201H in Wetzel County, West Virginia, Drilling under State Highway 89 and Harland Ridge Road.

Dear Ms. Adkins:

SWN Production Company, LLC ("SWN") is applying for a drilling permit for the above referenced well. The State of West Virginia has raised some concern as to SWN's right to drill under State Highway 89 and Harland Ridge Road. Please be advised that SWN has leased all mineral owners under said route as it relates to the above-referenced well and unit.

Thank you.

Sincerely,

Caleb Weaver  
Landman  
SWN Production Company, LLC  
PO Box 1300  
Jane Lew, WV 26378

Received  
Office of Oil & Gas  
JUN 15 2015  
A → V+

The Right People doing the Right Things,  
wisely Investing the cash flow from  
our underlying Assets, will create Value+




**Certification of Notice is hereby given:**

THEREFORE, I \_\_\_\_\_, have read and understand the notice requirements within West Virginia Code § 22-6A. I certify that as required under West Virginia Code § 22-6A, I have served the attached copies of the Notice Forms, identified above, to the required parties through personal service, by registered mail or by any method of delivery that requires a receipt or signature confirmation. I certify under penalty of law that I have personally examined and am familiar with the information submitted in this Notice Certification and all attachments, and that based on my inquiry of those individuals immediately responsible for obtaining the information, I believe that the information is true, accurate and complete. I am aware that there are significant penalties for submitting false information, including the possibility of fine and imprisonment.

Well Operator: SWN Production Co., LLC  
By: Dee Southall  
Its: Regulatory Supervisor  
Telephone: 832-796-1610

Address: P.O. Box 1300  
Jane Lew, WV 26378  
Facsimile: \_\_\_\_\_  
Email: Dee\_Southall@swn.com

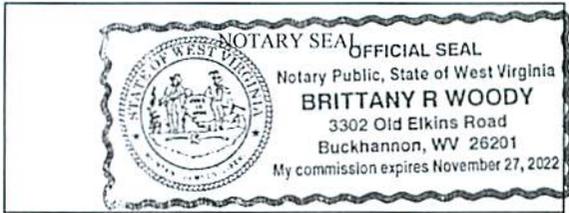

Subscribed and sworn before me this 1st day of June 2015  
Brittany R Woody Notary Public  
My Commission Expires 11/27/22

**Oil and Gas Privacy Notice:**

The Office of Oil and Gas processes your personal information, such as name, address and telephone number, as part of our regulatory duties. Your personal information may be disclosed to other State agencies or third parties in the normal course of business or as needed to comply with statutory or regulatory requirements, including Freedom of Information Act requests. Our office will appropriately secure your personal information. If you have any questions about our use or your personal information, please contact DEP's Chief Privacy Officer at [deprivacyofficer@wv.gov](mailto:deprivacyofficer@wv.gov).

Received  
Office of Oil & Gas  
June 15 2015  
Office of Oil & Gas  
JUN 15 2015

10303130

WW-6A  
(9-13)

API NO. 47-~~09~~ -  
OPERATOR WELL NO. William Ritchea Wtz 201H  
Well Pad Name: William Ritchea Wtz Pad

STATE OF WEST VIRGINIA  
DEPARTMENT OF ENVIRONMENTAL PROTECTION, OFFICE OF OIL AND GAS  
NOTICE OF APPLICATION

Notice Time Requirement: notice shall be provided no later than the filing date of permit application.

Date of Notice: 6/12/15 Date Permit Application Filed: 6/12/15

Notice of:

- PERMIT FOR ANY WELL WORK       CERTIFICATE OF APPROVAL FOR THE CONSTRUCTION OF AN IMPOUNDMENT OR PIT

Delivery method pursuant to West Virginia Code § 22-6A-10(b)

- PERSONAL SERVICE       REGISTERED MAIL       METHOD OF DELIVERY THAT REQUIRES A RECEIPT OR SIGNATURE CONFIRMATION

Pursuant to W. Va. Code § 22-6A-10(b) no later than the filing date of the application, the applicant for a permit for any well work or for a certificate of approval for the construction of an impoundment or pit as required by this article shall deliver, by personal service or by registered mail or by any method of delivery that requires a receipt or signature confirmation, copies of the application, the erosion and sediment control plan required by section seven of this article, and the well plat to each of the following persons: (1) The owners of record of the surface of the tract on which the well is or is proposed to be located; (2) The owners of record of the surface tract or tracts overlying the oil and gas leasehold being developed by the proposed well work, if the surface tract is to be used for roads or other land disturbance as described in the erosion and sediment control plan submitted pursuant to subsection (c), section seven of this article; (3) The coal owner, operator or lessee, in the event the tract of land on which the well proposed to be drilled is located [sic] is known to be underlain by one or more coal seams; (4) The owners of record of the surface tract or tracts overlying the oil and gas leasehold being developed by the proposed well work, if the surface tract is to be used for the placement, construction, enlargement, alteration, repair, removal or abandonment of any impoundment or pit as described in section nine of this article; (5) Any surface owner or water purveyor who is known to the applicant to have a water well, spring or water supply source located within one thousand five hundred feet of the center of the well pad which is used to provide water for consumption by humans or domestic animals; and (6) The operator of any natural gas storage field within which the proposed well work activity is to take place. (c)(1) If more than three tenants in common or other co-owners of interests described in subsection (b) of this section hold interests in the lands, the applicant may serve the documents required upon the person described in the records of the sheriff required to be maintained pursuant to section eight, article one, chapter eleven-a of this code. (2) Notwithstanding any provision of this article to the contrary, notice to a lien holder is not notice to a landowner, unless the lien holder is the landowner. W. Va. Code R. § 35-8-5.7.a requires, in part, that the operator shall also provide the Well Site Safety Plan ("WSSP") to the surface owner and any water purveyor or surface owner subject to notice and water testing as provided in section 15 of this rule.

Application Notice    WSSP Notice    E&S Plan Notice    Well Plat Notice is hereby provided to:

SURFACE OWNER(s)  
Name: William & Shirley Ritchea  
Address: HC Box 239  
New Martinsville, WV 26155  
Name: \_\_\_\_\_  
Address: \_\_\_\_\_

SURFACE OWNER(s) (Road and/or Other Disturbance)  
Name: \_\_\_\_\_  
Address: \_\_\_\_\_  
Name: \_\_\_\_\_  
Address: \_\_\_\_\_

SURFACE OWNER(s) (Impoundments or Pits)  
Name: \_\_\_\_\_  
Address: \_\_\_\_\_

COAL OWNER OR LESSEE  
Name: CNX Center %Leatherwood  
Address: 1000 Consol Energy Drive  
Canonsburg, PA 15317  
 COAL OPERATOR  
Name: \_\_\_\_\_  
Address: \_\_\_\_\_

SURFACE OWNER OF WATER WELL AND/OR WATER PURVEYOR(s)  
Name: William & Shirley Ritchea  
Address: HC Box 239  
New Martinsville, WV 26155

OPERATOR OF ANY NATURAL GAS STORAGE FIELD  
Name: \_\_\_\_\_  
Address: \_\_\_\_\_

Received  
Office of Oil & Gas  
JUN 15 2015

\*Please attach additional forms if necessary

**STATE OF WEST VIRGINIA  
DEPARTMENT OF ENVIRONMENTAL PROTECTION, OFFICE OF OIL AND GAS  
NOTICE OF APPLICATION**

**Notice Time Requirement:** notice shall be provided no later than the **filing date of permit application.**

**Date of Notice:** \_\_\_\_\_ **Date Permit Application Filed:** \_\_\_\_\_

**Notice of:**

- PERMIT FOR ANY WELL WORK
- CERTIFICATE OF APPROVAL FOR THE CONSTRUCTION OF AN IMPOUNDMENT OR PIT

**Delivery method pursuant to West Virginia Code § 22-6A-10(b)**

- PERSONAL SERVICE
- REGISTERED MAIL
- METHOD OF DELIVERY THAT REQUIRES A RECEIPT OR SIGNATURE CONFIRMATION

Pursuant to W. Va. Code § 22-6A-10(b) no later than the filing date of the application, the applicant for a permit for any well work or for a certificate of approval for the construction of an impoundment or pit as required by this article shall deliver, by personal service or by registered mail or by any method of delivery that requires a receipt or signature confirmation, copies of the application, the erosion and sediment control plan required by section seven of this article, and the well plat to each of the following persons: (1) The owners of record of the surface of the tract on which the well is or is proposed to be located; (2) The owners of record of the surface tract or tracts overlying the oil and gas leasehold being developed by the proposed well work, if the surface tract is to be used for roads or other land disturbance as described in the erosion and sediment control plan submitted pursuant to subsection (c), section seven of this article; (3) The coal owner, operator or lessee, in the event the tract of land on which the well proposed to be drilled is located [sic] is known to be underlain by one or more coal seams; (4) The owners of record of the surface tract or tracts overlying the oil and gas leasehold being developed by the proposed well work, if the surface tract is to be used for the placement, construction, enlargement, alteration, repair, removal or abandonment of any impoundment or pit as described in section nine of this article; (5) Any surface owner or water purveyor who is known to the applicant to have a water well, spring or water supply source located within one thousand five hundred feet of the center of the well pad which is used to provide water for consumption by humans or domestic animals; and (6) The operator of any natural gas storage field within which the proposed well work activity is to take place. (c)(1) If more than three tenants in common or other co-owners of interests described in subsection (b) of this section hold interests in the lands, the applicant may serve the documents required upon the person described in the records of the sheriff required to be maintained pursuant to section eight, article one, chapter eleven-a of this code. (2) Notwithstanding any provision of this article to the contrary, notice to a lien holder is not notice to a landowner, unless the lien holder is the landowner. W. Va. Code R. § 35-8-5.7.a requires, in part, that the operator shall also provide the Well Site Safety Plan ("WSSP") to the surface owner and any water purveyor or surface owner subject to notice and water testing as provided in section 15 of this rule.

Application Notice  WSSP Notice  E&S Plan Notice  Well Plat Notice is hereby provided to:

SURFACE OWNER(s)

Name: \_\_\_\_\_  
Address: \_\_\_\_\_

Name: \_\_\_\_\_  
Address: \_\_\_\_\_

SURFACE OWNER(s) (Road and/or Other Disturbance)

Name: \_\_\_\_\_  
Address: \_\_\_\_\_

Name: \_\_\_\_\_  
Address: \_\_\_\_\_

SURFACE OWNER(s) (Impoundments or Pits)

Name: \_\_\_\_\_  
Address: \_\_\_\_\_

COAL OWNER OR LESSEE

Name: \_\_\_\_\_  
Address: \_\_\_\_\_

COAL OPERATOR

Name: \_\_\_\_\_  
Address: \_\_\_\_\_

SURFACE OWNER OF WATER WELL AND/OR WATER PURVEYOR(s)

Name: Bernard Duelly  
Address: 1192 Waterloo Road  
Mogadore, OH 44260

OPERATOR OF ANY NATURAL GAS STORAGE FIELD

Name: \_\_\_\_\_  
Address: \_\_\_\_\_

\*Please attach additional forms if necessary

Received  
Office of Oil & Gas  
JUN 15 2015

**Notice is hereby given:**

Pursuant to West Virginia Code § 22-6A-10(b), notice is hereby given that the undersigned well operator has applied for a permit for well work or for a certificate of approval for the construction of an impoundment or pit.

**This Notice Shall Include:**

Pursuant to W. Va. Code § 22-6A-10(b), this notice shall include: (1) copies of the application; (2) the erosion and sediment control plan required by section seven of this article; and (3) the well plat.

Pursuant to W. Va. Code § 22-6A-10(f), this notice shall include: (1) a statement of the time limits for filing written comments; (2) who may file written comments; (3) the name and address of the secretary for the purpose of filing the comments and obtaining additional information; and (4) a statement that the persons may request, at the time of submitting written comments, notice of the permit decision and a list of persons qualified to test water.

Pursuant to W. Va. Code R. § 35-8-5.7.a, the operator shall provide the Well Site Safety Plan to the surface owner and any water purveyor or surface owner subject to notice and water testing as provided in section 15 of this rule.

Pursuant to W. Va. Code R. § 35-8-15.2.c, this notice shall: (1) contain a statement of the surface owner's and water purveyor's right to request sampling and analysis; (2) advise the surface owner and water purveyor of the rebuttable presumption for contamination or deprivation of a fresh water source or supply; advise the surface owner and water purveyor that refusal to allow the operator to conduct a pre-drilling water well test constitutes a method to rebut the presumption of liability; (3) advise the surface owner and water purveyor of his or her independent right to sample and analyze any water supply at his or her own expense; advise the surface owner and water purveyor whether or not the operator will utilize an independent laboratory to analyze any sample; and (4) advise the surface owner and or water purveyor that he or she can obtain from the Chief a list of water testing laboratories in the subject area capable of and qualified to test water supplies in accordance with standard acceptable methods.

Additional information related to horizontal drilling may be obtained from the Secretary, at the WV Department of Environmental Protection headquarters, located at 601 57<sup>th</sup> Street, SE, Charleston, WV 25304 (304-926-0450) or by visiting [www.dep.wv.gov/oil-and-gas/pages/default.aspx](http://www.dep.wv.gov/oil-and-gas/pages/default.aspx).

**Well Location Restrictions**

Pursuant to W. Va. Code § 22-6A-12, Wells may not be drilled within two hundred fifty feet measured horizontally from any existing water well or developed spring used for human or domestic animal consumption. The center of well pads may not be located within six hundred twenty-five feet of an occupied dwelling structure, or a building two thousand five hundred square feet or larger used to house or shelter dairy cattle or poultry husbandry. This limitation is applicable to those wells, developed springs, dwellings or agricultural buildings that existed on the date a notice to the surface owner of planned entry for surveying or staking as provided in section ten of this article or a notice of intent to drill a horizontal well as provided in subsection (b), section sixteen of this article was provided, whichever occurs first, and to any dwelling under construction prior to that date. This limitation may be waived by written consent of the surface owner transmitted to the department and recorded in the real property records maintained by the clerk of the county commission for the county in which such property is located. Furthermore, the well operator may be granted a variance by the secretary from these distance restrictions upon submission of a plan which identifies the sufficient measures, facilities or practices to be employed during well site construction, drilling and operations. The variance, if granted, shall include terms and conditions the department requires to ensure the safety and protection of affected persons and property. The terms and conditions may include insurance, bonding and indemnification, as well as technical requirements. (b) No well pad may be prepared or well drilled within one hundred feet measured horizontally from any perennial stream, natural or artificial lake, pond or reservoir, or a wetland, or within three hundred feet of a naturally reproducing trout stream. No well pad may be located within one thousand feet of a surface or ground water intake of a public water supply. The distance from the public water supply as identified by the department shall be measured as follows: (1) For a surface water intake on a lake or reservoir, the distance shall be measured from the boundary of the lake or reservoir. (2) For a surface water intake on a flowing stream, the distance shall be measured from a semicircular radius extending upstream of the surface water intake. (3) For a groundwater source, the distance shall be measured from the wellhead or spring. The department may, in its discretion, waive these distance restrictions upon submission of a plan identifying sufficient measures, facilities or practices to be employed during well site construction, drilling and operations to protect the waters of the state. A waiver, if granted, shall impose any permit conditions as the secretary considers necessary. (c) Notwithstanding the foregoing provisions of this section, nothing contained in this section prevents an operator from conducting the activities permitted or authorized by a Clean Water Act Section 404 permit or other approval from the United States Army Corps of Engineers within any waters of the state or within the restricted areas referenced in this section. (d) The well location restrictions set forth in this section shall not apply to any well on a multiple well pad if at least one of the wells was permitted prior to the effective date of this article. (e) The secretary shall, by December 31, 2012, report to the Legislature on the noise, light, dust and volatile organic compounds generated by the drilling of horizontal wells as they relate to the well location restrictions regarding occupied dwelling structures pursuant to this section. Upon a finding, if any, by the secretary that the well location restrictions regarding occupied dwelling structures are inadequate or otherwise require alteration to address the items

examined in the study required by this subsection, the secretary shall have the authority to propose for promulgation legislative rules establishing guidelines and procedures regarding reasonable levels of noise, light, dust and volatile organic compounds relating to drilling horizontal wells, including reasonable means of mitigating such factors, if necessary.

**Water Well Testing:**

Pursuant to West Virginia Code § 22-6A-10(d), notification shall be made, with respect to surface landowners identified in subsection (b) or water purveyors identified in subdivision (5), subsection (b) of this section, of the opportunity for testing their water well. The operator shall provide an analysis to such surface landowner or water purveyor at their request.

**Water Testing Laboratories:**

Pursuant to West Virginia Code § 22-6A-10(i), persons entitled to notice pursuant to subsection (b) of this section may contact the department to ascertain the names and locations of water testing laboratories in the subject area capable and qualified to test water supplies in accordance with standard accepted methods. In compiling that list of names the department shall consult with the state Bureau for Public Health and local health departments. A surface owner and water purveyor has an independent right to sample and analyze any water supply at his or her own expense. The laboratory utilized by the operator shall be approved by the agency as being certified and capable of performing sample analyses in accordance with this section.

**Rebuttable Presumption for Contamination or Deprivation of a Fresh Water Source or Supply:**

W. Va. Code § 22-6A-18 requires that (b) unless rebutted by one of the defenses established in subsection (c) of this section, in any action for contamination or deprivation of a fresh water source or supply within one thousand five hundred feet of the center of the well pad for horizontal well, there is a rebuttable presumption that the drilling and the oil or gas well or either was the proximate cause of the contamination or deprivation of the fresh water source or supply. (c) In order to rebut the presumption of liability established in subsection (b) of this section, the operator must prove by a preponderance of the evidence one of the following defenses: (1) The pollution existed prior to the drilling or alteration activity as determined by a predrilling or prealteration water well test. (2) The landowner or water purveyor refused to allow the operator access to the property to conduct a predrilling or prealteration water well test. (3) The water supply is not within one thousand five hundred feet of the well. (4) The pollution occurred more than six months after completion of drilling or alteration activities. (5) The pollution occurred as the result of some cause other than the drilling or alteration activity. (d) Any operator electing to preserve its defenses under subdivision (1), subsection (c) of this section shall retain the services of an independent certified laboratory to conduct the predrilling or prealteration water well test. A copy of the results of the test shall be submitted to the department and the surface owner or water purveyor in a manner prescribed by the secretary. (e) Any operator shall replace the water supply of an owner of interest in real property who obtains all or part of that owner's supply of water for domestic, agricultural, industrial or other legitimate use from an underground or surface source with a comparable water supply where the secretary determines that the water supply has been affected by contamination, diminution or interruption proximately caused by the oil or gas operation, unless waived in writing by that owner. (f) The secretary may order the operator conducting the oil or gas operation to: (1) Provide an emergency drinking water supply within twenty-four hours; (2) Provide temporary water supply within seventy-two hours; (3) Within thirty days begin activities to establish a permanent water supply or submit a proposal to the secretary outlining the measures and timetables to be used in establishing a permanent supply. The total time in providing a permanent water supply may not exceed two years. If the operator demonstrates that providing a permanent replacement water supply cannot be completed within two years, the secretary may extend the time frame on case-by-case basis; and (4) Pay all reasonable costs incurred by the real property owner in securing a water supply. (g) A person as described in subsection (b) of this section aggrieved under the provisions of subsections (b), (e) or (f) of this section may seek relief in court... (i) Notwithstanding the denial of the operator of responsibility for the damage to the real property owner's water supply or the status of any appeal on determination of liability for the damage to the real property owner's water supply, the operator may not discontinue providing the required water service until authorized to do so by the secretary or a court of competent jurisdiction.

**Written Comment:**

Pursuant to West Virginia Code § 22-6A-11(a), all persons described in subsection (b), section ten of this article may file written comments with the secretary as to the location or construction of the applicant's proposed well work within thirty days after the application is filed with the secretary. All persons described in West Virginia Code § 22-6A-10(b) may file written comments as to the location or construction of the applicant's proposed well work to the Secretary at:

Chief, Office of Oil and Gas  
Department of Environmental Protection  
601 57<sup>th</sup> St. SE  
Charleston, WV 25304  
(304) 926-0450

Received  
Office of Oil & Gas  
JUN 15 2015

Such persons may request, at the time of submitting written comments, notice of the permit decision and a list of persons qualified to test water. **NOTE: YOU ARE NOT REQUIRED TO FILE ANY COMMENT.**

**Time Limits and Methods for Filing Comments.**

The law requires these materials to be served on or before the date the operator files its Application. You have **THIRTY (30) DAYS** after the filing date to file your comments. Comments must be filed in person or received in the mail by the Chief's office by the time stated above. You may call the Chief's office to be sure of the date. Check with your postmaster to ensure adequate delivery time or to arrange special expedited handling. If you have been contacted by the well operator and you have signed a "voluntary statement of no objection" to the planned work described in these materials, then the permit may be issued at any time.

Pursuant to West Virginia Code § 22-6A-11(c)(2), Any objections of the affected coal operators and coal seam owners and lessees shall be addressed through the processes and procedures that exist under sections fifteen, seventeen and forty, article six of this chapter, as applicable and as incorporated into this article by section five of this article. The written comments filed by the parties entitled to notice under subdivisions (1), (2), (4), (5) and (6), subsection (b), section ten of this article shall be considered by the secretary in the permit issuance process, but the parties are not entitled to participate in the processes and proceedings that exist under sections fifteen, seventeen or forty, article six of this chapter, as applicable and as incorporated into this article by section five of this article.

**Comment Requirements**

Your comments must be in writing and include your name, address and telephone number, the well operator's name and well number and the approximate location of the proposed well site including district and county from the application. You may add other documents, such as sketches, maps or photographs to support your comments.

Disclaimer: All comments received will be placed on our web site <http://www.dep.wv.gov/oil-and-gas/Horizontal-Permits/Pages/default.aspx> and the applicant will automatically be forwarded an email notice that such comments have been submitted. The applicant will be expected to provide a response to comments submitted by any surface owner, water purveyor or natural gas storage operator noticed within the application.

**Permit Denial or Condition**

The Chief has the power to deny or condition a well work permit. Pursuant to West Virginia Code § 22-6A-8(d), the permit may not be issued or be conditioned, including conditions with respect to the location of the well and access roads prior to issuance if the director determines that:

- (1) The proposed well work will constitute a hazard to the safety of persons;
- (2) The plan for soil erosion and sediment control is not adequate or effective;
- (3) Damage would occur to publicly owned lands or resources; or
- (4) The proposed well work fails to protect fresh water sources or supplies.

A permit may also be denied under West Virginia Code § 22-6A-7(k), the secretary shall deny the issuance of a permit if the secretary determines that the applicant has committed a substantial violation of a previously issued permit for a horizontal well, including the applicable erosion and sediment control plan associated with the previously issued permit, or a substantial violation of one or more of the rules promulgated under this article, and in each instance has failed to abate or seek review of the violation within the time prescribed by the secretary pursuant to the provisions of subdivisions (1) and (2), subsection (a), section five of this article and the rules promulgated hereunder, which time may not be unreasonable.

Pursuant to West Virginia Code § 22-6A-10(g), any person entitled to submit written comments to the secretary pursuant to subsection (a), section eleven of this article, shall also be entitled to receive from the secretary a copy of the permit as issued or a copy of the order modifying or denying the permit if the person requests receipt of them as a part of the written comments submitted concerning the permit application. Such persons may request, at the time of submitting written comments, notice of the permit decision and a list of persons qualified to test water.

Received  
Office of Oil & Gas  
Office of Oil & Gas  
JUN 15 2015  
JUN 15 2015

WW-6A  
(8-13)

API NO. 47-10303130  
OPERATOR WELL NO. William Ritchea WTZ 201H  
Well Pad Name: William Ritchea WTZ Pad

**Notice is hereby given by:**

Well Operator: SWN Production Co., LLC  
Telephone: 832-796-1610  
Email: Dee\_Southall@swn.com



Address: P.O. Box 1300  
Jane Lew, WV 26378  
Facsimile: \_\_\_\_\_

**Oil and Gas Privacy Notice:**

The Office of Oil and Gas processes your personal information, such as name, address and telephone number, as part of our regulatory duties. Your personal information may be disclosed to other State agencies or third parties in the normal course of business or as needed to comply with statutory or regulatory requirements, including Freedom of Information Act requests. Our office will appropriately secure your personal information. If you have any questions about our use or your personal information, please contact DEP's Chief Privacy Officer at [depprivacyofficer@wv.gov](mailto:depprivacyofficer@wv.gov).




Subscribed and sworn before me this 1st day of June 2015.  
Brittany R Woody Notary Public  
My Commission Expires 11/27/2022

Received  
Office of Oil & Gas  
JUN 15 2015




320 O'Bryan Lane • Van Buren, AR 72956  
Office: 479.474.7916 • Fax: 479.474.2450  
Surveying • handa-inc.com

GRID NORTH  
UTM, NAD83 DATUM, ZONE 17, US FT

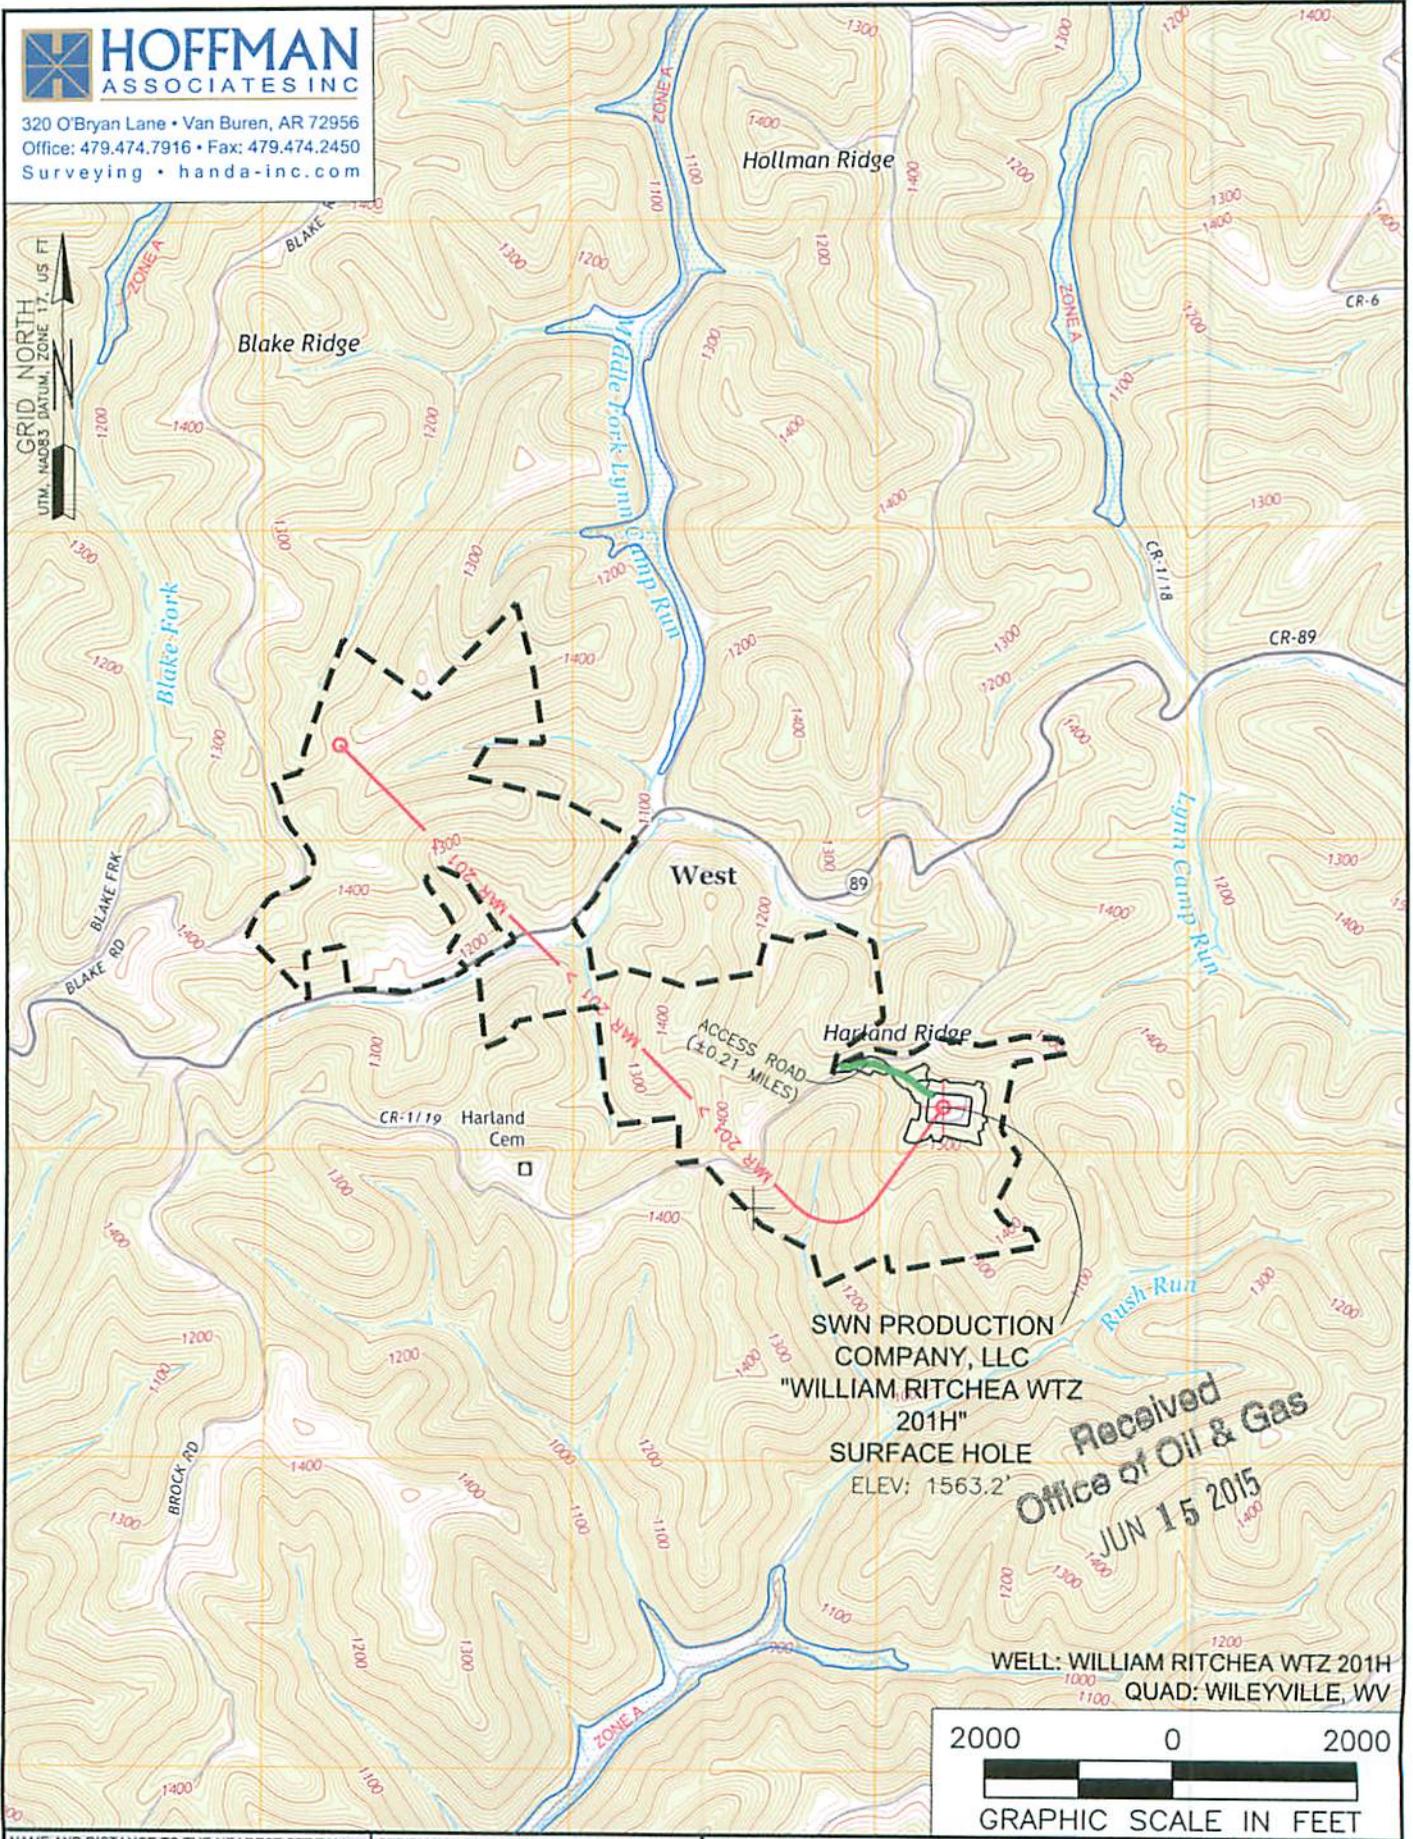

Received  
Office of Oil & Gas  
JUN 15 2015

WELL: WILLIAM RITCHEA Wtz 201H  
QUAD: WILEYVILLE, WV

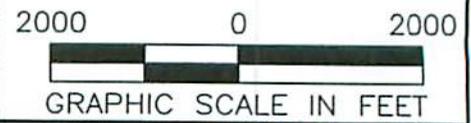

<b>NAME AND DISTANCE TO THE NEAREST STREAM:</b> AN UNNAMED TRIBUTARY OF RUSH RUN IS LOCATED ±0.27 MILES SOUTHWEST OF THE CENTER OF THE DRILL PAD.		<b>STREAM CROSSING COORDINATES (NAD 83):</b> NO NEW CROSSINGS.		<b>COMPANY:</b> 	
<b>WELL RESTRICTIONS:</b> WELL PAD, LOD, & E & S CONTROL FEATURES TO PERENNIAL STREAM, LAKE, POND, RESERVOIR OR WETLAND: >100 FEET WELL PAD, LOD, & E & S CONTROL FEATURES TO NATURALLY PRODUCING TROUT STREAM: >300 FEET WELL PAD, LOD, & E & S CONTROL FEATURES TO GROUNDWATER INTAKE OR PUBLIC WATER SUPPLY: >1000 FEET WELL SHL TO EXISTING WATER WELL OR DEVELOPED SPRING: >250 FEET CENTER OF PAD TO OCCUPIED DWELLING STRUCTURE: >625 FEET CENTER OF PAD TO AGRICULTURAL BUILDINGS LARGER THAN 2500 SQ FT: >625 FEET		<b>OPERATOR'S</b> WILLIAM RITCHEA Wtz			
<b>FEMA FLOOD INFORMATION:</b> BY GRAPHIC PLOTTING ONLY FEMA FIRM INCORPORATED AREA OF WETZEL COUNTY, WEST VIRGINIA; MAP NUMBER 54103C0075C; EFFECTIVE DATE: SEPTEMBER 25, 2009.		<b>WELL #:</b> 201H		<b>LOCATION:</b> PROCTOR DISTRICT, WETZEL COUNTY, WEST VIRGINIA	
<b>LEGEND:</b> ○ PROPOSED SURFACE HOLE / BOTTOM HOLE ⊗ EXISTING / PRODUCING WELLHEAD ⊗ ABANDONED WELL ⊗ PLUGGED & ABANDONED WELL △ CUT CONDUCTOR		<b>ACCESS ROAD</b> ACCESS ROAD TO PREV. SITE <b>HIGHWAY/INTERSTATE</b> COUNTY ROAD		<b>SURFACE HOLE LOCATION:</b> GEOGRAPHIC (NAD83): LATITUDE: 39.669606" LONGITUDE: -80.659437"	
		<b>BOTTOM HOLE LOCATION:</b> GEOGRAPHIC (NAD83): LATITUDE: 39.680183" LONGITUDE: -80.682293"		<b>REVISIONS:</b> DATE: 05-14-2015	
				DRAWN BY: S. HUTSON SCALE: 1" = 2000' DRAWING NO: 58715 TOPOGRAPHIC MAP	

**STATE OF WEST VIRGINIA  
DEPARTMENT OF ENVIRONMENTAL PROTECTION, OFFICE OF OIL AND GAS  
NOTICE OF INTENT TO DRILL**

Pursuant to W. Va. Code § 22-6A-16(b), the Notice of Intent to Drill is only required if the notice requirements of W. Va. Code § 22-6A-10(a) have NOT been met or if the Notice of Intent to Drill requirement has NOT been waived in writing by the surface owner.

**Notice Time Requirement:** Notice shall be provided at least **TEN (10)** days prior to filing a permit application.  
**Date of Notice:** 05/28/2015      **Date Permit Application Filed:** 6/12/15

**Delivery method pursuant to West Virginia Code § 22-6A-16(b)**

- HAND DELIVERY       CERTIFIED MAIL RETURN RECEIPT REQUESTED

Pursuant to W. Va. Code § 22-6A-16(b), at least ten days prior to filing a permit application, an operator shall, by certified mail return receipt requested or hand delivery, give the surface owner notice of its intent to enter upon the surface owner's land for the purpose of drilling a horizontal well: *Provided*, That notice given pursuant to subsection (a), section ten of this article satisfies the requirements of this subsection as of the date the notice was provided to the surface owner: *Provided, however*, That the notice requirements of this subsection may be waived in writing by the surface owner. The notice, if required, shall include the name, address, telephone number, and if available, facsimile number and electronic mail address of the operator and the operator's authorized representative.

**Notice is hereby provided to the SURFACE OWNER(s):**

Name: William D. & Shirley E. Ritchea      Name: \_\_\_\_\_  
Address: HC 60 Box 239      Address: \_\_\_\_\_  
New Martinsville, WV 26155

**Notice is hereby given:**

Pursuant to West Virginia Code § 22-6A-16(b), notice is hereby given that the undersigned well operator has an intent to enter upon the surface owner's land for the purpose of drilling a horizontal well on the tract of land as follows:

State: West Virginia      UTM NAD 83      Easting: 529,210.013  
County: Wetzel      Northing: 4,391,143.194  
District: Proctor      Public Road Access: Harland Ridge RT 1/19  
Quadrangle: Wileyville      Generally used farm name: \_\_\_\_\_  
Watershed: Middle Ohio North

**This Notice Shall Include:**

Pursuant to West Virginia Code § 22-6A-16(b), this notice shall include the name, address, telephone number, and if available, facsimile number and electronic mail address of the operator and the operator's authorized representative. Additional information related to horizontal drilling may be obtained from the Secretary, at the WV Department of Environmental Protection headquarters, located at 601 57<sup>th</sup> Street, SE, Charleston, WV 25304 (304-926-0450) or by visiting [www.dep.wv.gov/oil-and-gas/pages/default.aspx](http://www.dep.wv.gov/oil-and-gas/pages/default.aspx).

**Notice is hereby given by:**

Well Operator: SWN Production Company, LLC      Authorized Representative: Danielle Southall  
Address: PO Box 1300, 179 Innovation Drive      Address: PO Box 1300, 179 Innovation Drive  
Jane Lew, WV 26378      Jane Lew, WV 26378  
Telephone: 304-884-1611      Telephone: 304-884-1614  
Email: micah\_feather@swn.com      Email: Danielle\_Southall@swn.com  
Facsimile: \_\_\_\_\_      Facsimile: \_\_\_\_\_

**Received**  
**Office of Oil & Gas**  
**JUN 15 2015**

**Oil and Gas Privacy Notice:**

The Office of Oil and Gas processes your personal information, such as name, address and telephone number, as part of our regulatory duties. Your personal information may be disclosed to other State agencies or third parties in the normal course of business or as needed to comply with statutory or regulatory requirements, including Freedom of Information Act requests. Our office will appropriately secure your personal information. If you have any questions about our use or your personal information, please contact DEP's Chief Privacy Officer at [depprivacyofficer@wv.gov](mailto:depprivacyofficer@wv.gov).

**STATE OF WEST VIRGINIA  
DEPARTMENT OF ENVIRONMENTAL PROTECTION, OFFICE OF OIL AND GAS  
NOTICE OF PLANNED OPERATION**

**Notice Time Requirement:** notice shall be provided no later than the **filing date of permit application.**  
**Date of Notice:** 05/28/2015      **Date Permit Application Filed:** 5/11/15

**Delivery method pursuant to West Virginia Code § 22-6A-16(c)**

- CERTIFIED MAIL                                       HAND
- RETURN RECEIPT REQUESTED                                      DELIVERY

Pursuant to W. Va. Code § 22-6A-16(c), no later than the date for filing the permit application, an operator shall, by certified mail return receipt requested or hand delivery, give the surface owner whose land will be used for the drilling of a horizontal well notice of the planned operation. The notice required by this subsection shall include: (1) A copy of this code section; (2) The information required to be provided by subsection (b), section ten of this article to a surface owner whose land will be used in conjunction with the drilling of a horizontal well; and (3) A proposed surface use and compensation agreement containing an offer of compensation for damages to the surface affected by oil and gas operations to the extent the damages are compensable under article six-b of this chapter. (d) The notices required by this section shall be given to the surface owner at the address listed in the records of the sheriff at the time of notice.

**Notice is hereby provided to the SURFACE OWNER(s)**  
(at the address listed in the records of the sheriff at the time of notice):

Name: <u>William D. &amp; Shirley E. Ritchea</u> ✓	Name: _____
Address: <u>HC 60 Box 239</u>	Address: _____
<u>New Martinsville, WV 26155</u>	_____

**Notice is hereby given:**

Pursuant to West Virginia Code § 22-6A-16(c), notice is hereby given that the undersigned well operator has developed a planned operation on the surface owner's land for the purpose of drilling a horizontal well on the tract of land as follows:

State: <u>West Virginia</u>	UTM NAD 83	Easting: <u>529,210.013</u>	
County: <u>Wetzel</u>		Northing: <u>4,391,143.194</u>	
District: <u>Proctor</u>	Public Road Access: <u>Harland Ridge RT 1/19</u>		
Quadrangle: <u>Wileyville</u>	Generally used farm name: _____		
Watershed: <u>Upper Ohio</u>			

**This Notice Shall Include:**

Pursuant to West Virginia Code § 22-6A-16(c), this notice shall include: (1) A copy of this code section; (2) The information required to be provided by W. Va. Code § 22-6A-10(b) to a surface owner whose land will be used in conjunction with the drilling of a horizontal well; and (3) A proposed surface use and compensation agreement containing an offer of compensation for damages to the surface affected by oil and gas operations to the extent the damages are compensable under article six-b of this chapter. Additional information related to horizontal drilling may be obtained from the Secretary, at the WV Department of Environmental Protection headquarters, located at 601 57<sup>th</sup> Street, SE, Charleston, WV 25304 (304-926-0450) or by visiting [www.dep.wv.gov/oil-and-gas/pages/default.aspx](http://www.dep.wv.gov/oil-and-gas/pages/default.aspx).

Well Operator: <u>SWN Production Company, LLC</u>	Address: <u>PO Box 1300, 179 Innovation Drive</u>
Telephone: <u>304-884-1614</u>	<u>Jane Lew, WV 26378</u>
Email: <u>Danielle_Southall@swn.com</u>	Facsimile: <u>304-472-4225</u>

**Received**  
**Office of Oil & Gas**  
**JUN 15 2015**

**Oil and Gas Privacy Notice:**

The Office of Oil and Gas processes your personal information, such as name, address and telephone number, as part of our regulatory duties. Your personal information may be disclosed to other State agencies or third parties in the normal course of business or as needed to comply with statutory or regulatory requirements, including Freedom of Information Act requests. Our office will appropriately secure your personal information. If you have any questions about our use or your personal information, please contact DEP's Chief Privacy Officer at [depprivacyofficer@wv.gov](mailto:depprivacyofficer@wv.gov).



10303130

WEST VIRGINIA DEPARTMENT OF TRANSPORTATION  
**Division of Highways**

1900 Kanawha Boulevard East • Building Five • Room 110  
Charleston, West Virginia 25305-0430 • (304) 558-3505

Earl Ray Tomblin  
Governor

Paul A. Mattox, Jr., P. E.  
Secretary of Transportation/  
Commissioner of Highways

May 29, 2015

James A. Martin, Chief  
Office of Oil and Gas  
Department of Environmental Protection  
601 57<sup>th</sup> Street, SE  
Charleston, WV 25304

Subject: DOH Permit for the William Ritchea Pad WTZ 201H Well Site, Wetzel County

Dear Mr. Martin,

The West Virginia Division of Highways has issued permit 06-2011-0618 to Southwestern Energy for access to the State Road for the well site located off of Wetzel County Route 1/19 SLS.

The operator has signed an OIL AND GAS ROAD MAINTENANCE BONDING AGREEMENT and provided the required Bond. This operator is currently in compliance with the DOH OIL AND GAS POLICY dated January 3, 2012.

Very Truly Yours,

Gary K. Clayton  
Regional Maintenance Engineer  
Central Office Oil & Gas Coordinator

Received  
Office of Oil & Gas  
JUN 15 2015

Cc: Brittany Woody  
Southwestern Energy  
CH, OM, D-6  
File

10303130

Supplier Name	Product Name	Product Use	Chemical Name	CAS Number
NALCO ONESOURCE	EC6110A	Biocide	Ethanol	000064-17-5
			Glutaraldehyde (Pentanediol)	000111-30-8
			Quaternary Ammonium Compounds	N/A-063
	EC6629A	Biocide	No Hazardous Components	NONE
WEATHERFORD	WBK-133 OXIDIZER	Breaker	Ammonium Persulfate	007727-54-0
	WBK-134	Breaker	Ammonium Persulfate	007727-54-0
			Crystalline Silica (Quartz Sand, Silicon Dioxide)	014808-60-7
	WCS-631LC	Clay Stabilizer	Proprietary Non Hazardous Salt	N/A-229
			Water	007732-18-5
	WFR-55LA	Friction Reducer	No Hazardous Components	NONE
	WGA-15L	Gel	Petroleum Distillate Hydrotreated Light	064742-47-8
	WPB-584-L	Buffer	Potassium Carbonate	000584-08-7
			Potassium Hydroxide	001310-58-3
	WXL-101LE	Corsslinker	No Hazardous Components	NONE
	WXL-101LM	Crosslinker	Petroleum Distillate Hydrotreated Light	064742-47-8
	WXL-105L	Crosslinker	Water	007732-18-5
			Ethylene Glycol	000107-21-1
Boric Acid			010043-35-3	
Ethanolamine			000141-43-5	
SCHLUMBERGER	B244 Green-Cide 25G	Biocide	Glutaraldehyde	111-30-8
	L071 Temporary Clay Stabilizer	Clay Stabilizer	Cholinium Chloride	67-48-1
	Breaker J218	Breaker	Diammonium Peroxidisulphate	7727-54-0
	EB-Clean* J475 Breaker		Diammonium Peroxidisulphate	7727-54-0
	Friction Reducer B315	Friction Reducer	Distillates (petroleum), Hydrotreated light Aliphatic Alcohol Glycol Ether	64742-47-8 Proprietary
	Friction Reducer J609		Ammonium Sulfate	7783-20-2

Received  
Office of Oil & Gas  
JUN 15 2015

10303130

Supplier Name	Product Name	Product Use	Chemical Name	CAS Number
SCHLUMBERGER	Water Gelling Agent J580	Gel	Carbohydrate Polymer	Proprietary
	Scale Inhibitor B317	Scale Inhibitor	Trisodium ortho phosphate Ethane-1, 2-diol	7601-54-9 107-21-1
	Borate Crosslinker J532	Crosslinker	Aliphatic polyol Sodium tetraborate decahydrate	Proprietary 1303 96-4
	Crosslinker J610		Aliphatic polyol Potassium hydroxide	Proprietary 1310 58-3

Received  
Office of Oil & Gas  
JUN 15 2015


Supplier Name	Product Name	Product Use	Chemical Name	CAS Number
BAKER HUGHES	ALPHA 1427	Biocida	Didecyl Dimethyl Ammonium Chloride	007173-51-1
			Ethanol	000064-17-5
			Glutaraldehyde (Pentanediol)	000111-30-8
			Quaternary Ammonium Compound	068424-85-1
			Water	007732-18-5
	BF-7L	Buffer	Potassium Carbonate	000584-08-7
	ClayCare	Clay Stabilizer	Choline Chloride	000067-48-1
			Water	007732-18-5
	Enzyme G-I	Breaker	No Hazardous Components	NONE
	ENZYME G-NE	Breaker	No Hazardous Components	NONE
	FRW-18	Friction Reducer	Petroleum Distillate Hydrotreated Light	064742-47-8
	GW-3LDF	Gel	Petroleum Distillate Blend	N/A-014
			Polysaccharide Blend	N/A-021
	SCALETROL 720	Scale Inhibitor	Diethylene Glycol	000111-46-6
Ethylene Glycol			000107-21-1	
XLW-32	Crosslinker	Boric Acid	010043-35-3	
		Methanol (Methyl Alcohol)	000067-56-1	
FRAC TECH SERVICES	APB01 (AMMONIUM PERSUFATE BREAKER)	Breaker	Ammonium Persulfate	007727-54-0
	B05 (LOW PH BUFFER)	Buffer	Acetic acid	000064-19-7
	BXL03 Borate XL Delayed High Temp	Crosslinker	No Hazardous Components	NONE
	FRW-200	Friction Reducer	No Hazardous Components	NONE
	HVG01 (TURQUOISE-1 BULK)	Gelling Agent	Petroleum Distillate Hydrotreated Light	064742-47-8
	KCLS-4	Clay Stabilizer	No Hazardous Components	NONE
	LTB-1	Breaker	Ammonium Persulfate	N/A

Received  
Office of Oil & Gas  
JUN 15 2015


# AS-BUILT SITE PLAN FOR WILLIAM & SHIRLEY RITCHEA WTZ PAD A PROCTOR DISTRICT, WETZEL COUNTY, WEST VIRGINIA



DRAWN BY: JAR  
DATE: 07/29/2015  
SCALE: AS SHOWN  
DWG. NO. 087555005

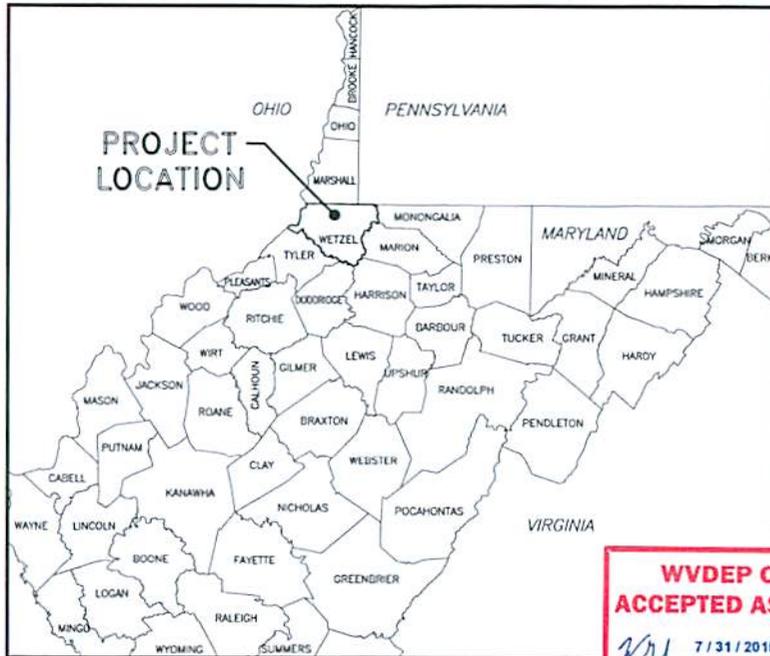

COUNTY MAP  
N.T.S.

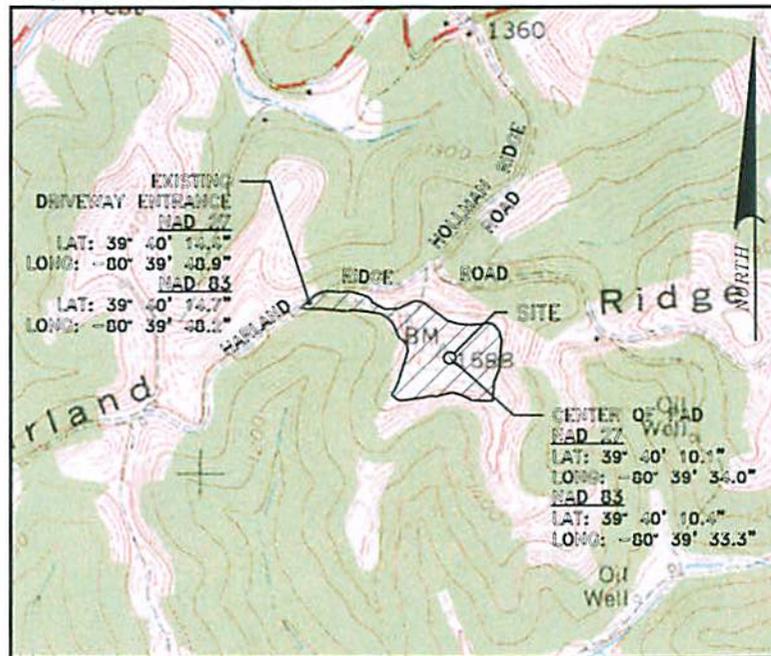

LOCATION MAP  
SCALE - 1"=1000'

**WVDEP OOG  
ACCEPTED AS-BUILT**

*WJL* 7/31/2015

**WEST VIRGINIA 811**  
CALL BEFORE YOU DIG!  
Dial 811 or 800.245.4848  
Miss Utility of West Virginia

**SWN**  
Southwestern Energy®

**OPERATOR**  
SWN PRODUCTION CO., LLC  
ATTN: OEE SOUTHWALL  
P.O. BOX 1300  
JANE LEW, WV 26378  
(832) 795-1514

**SITE DATA**

TOTAL DISTURBED AREA: 13.6 ACRES  
ROAD DISTURBED AREA: 3.9 ACRES  
PAD DISTURBED ACRES: 9.7 ACRES  
ACCESS ROAD LENGTH: 1,079'  
ACCESS ROAD AVERAGE WIDTH: 24'  
WELL PAD ELEVATION: 1,563.0'

**WELL API NUMBERS**

1H	API 103-03128
	ISSUED 06/15/15
3H	API 103-03129
	ISSUED 06/15/15
5H	NOT PERMITTED
6H	NOT PERMITTED
201H	API 103-03130
	ISSUED 06/15/15
205H	NOT PERMITTED
410H	API 103-03134
	ISSUED 07/23/15

**LIST OF DRAWINGS**


1	OF 14	COVER SHEET
2-3	OF 14	EVACUATION ROUTE/ PREVAILING WINDS
4	OF 14	AS-BUILT SITE PLAN OVERVIEW
5-9	OF 14	AS-BUILT SITE PLAN
10-12	OF 14	RECLAMATION PLAN
13	OF 14	ACCESS DRIVE PROFILE
14	OF 14	DETAILS

SHEET 1 OF 14

**RETTEW**

RETTEW ASSOCIATES, INC.  
5143 Sycamore Road, 100 North Center, OH 44720  
Phone (330) 818-5770 Fax (330) 818-5750  
www.retrew.com


COVER SHEET FOR  
**WILLIAM & SHIRLEY RITCHEA**  
**WTZ PAD A**  
WETZEL COUNTY, WV  
PROCTOR DISTRICT

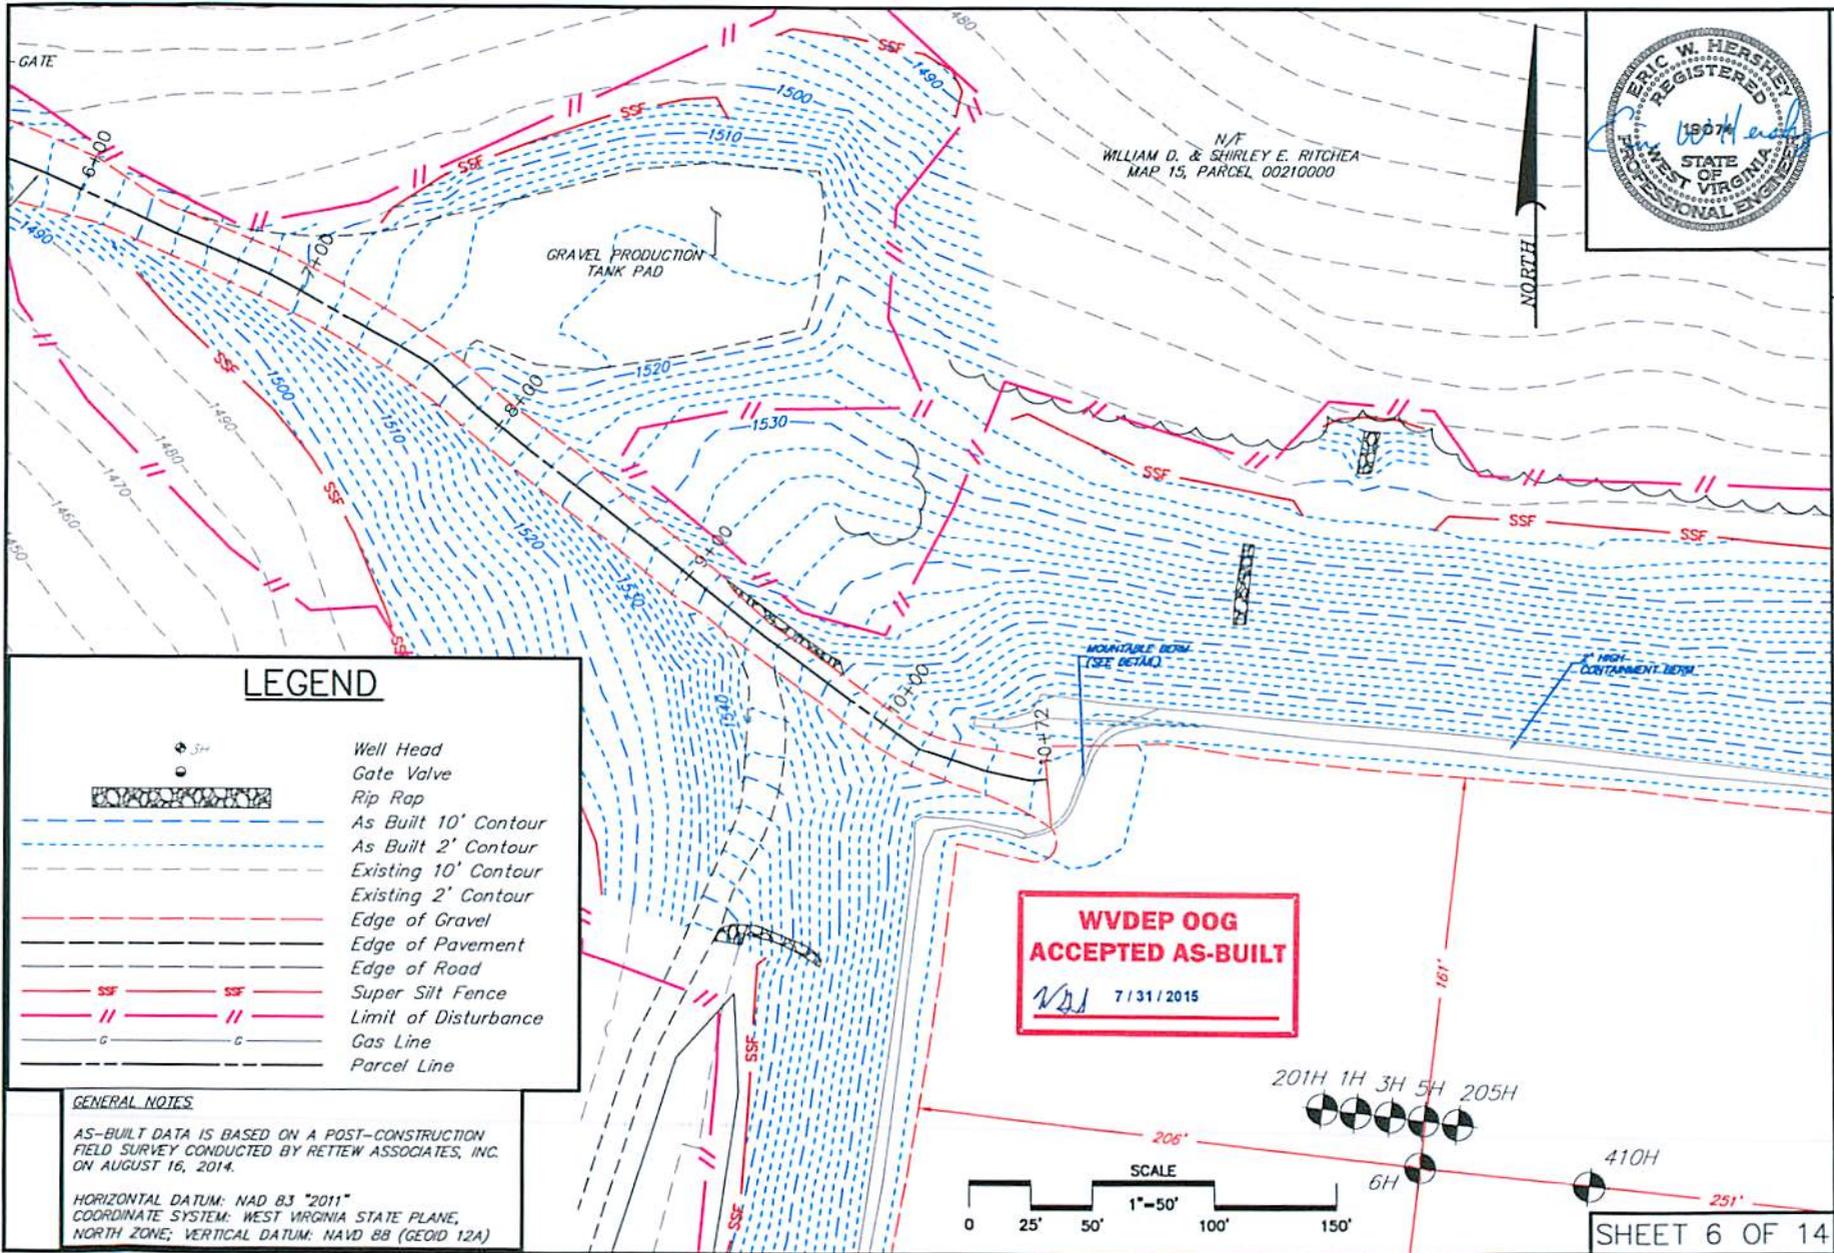


DRAWN BY: JAR  
 DATE: 07/29/2015  
 SCALE: 1" = 50'  
 DWG. NO. 087569009

**RETTEW**  
 RETTEW Associates, Inc.  
 5143 Stonem Road, Suite 100, North Canton, OH 44720  
 Phone (330) 818-8770 • Fax (330) 818-9760  
 Civil • Survey • Erosion Control • Construction • Environmental Consulting

AS-BUILT SITE PLAN FOR  
**WILLIAM & SHIRLEY RITCHEA**  
**WTZ PAD A**  
 WETZEL COUNTY, WV  
 PROCTOR DISTRICT

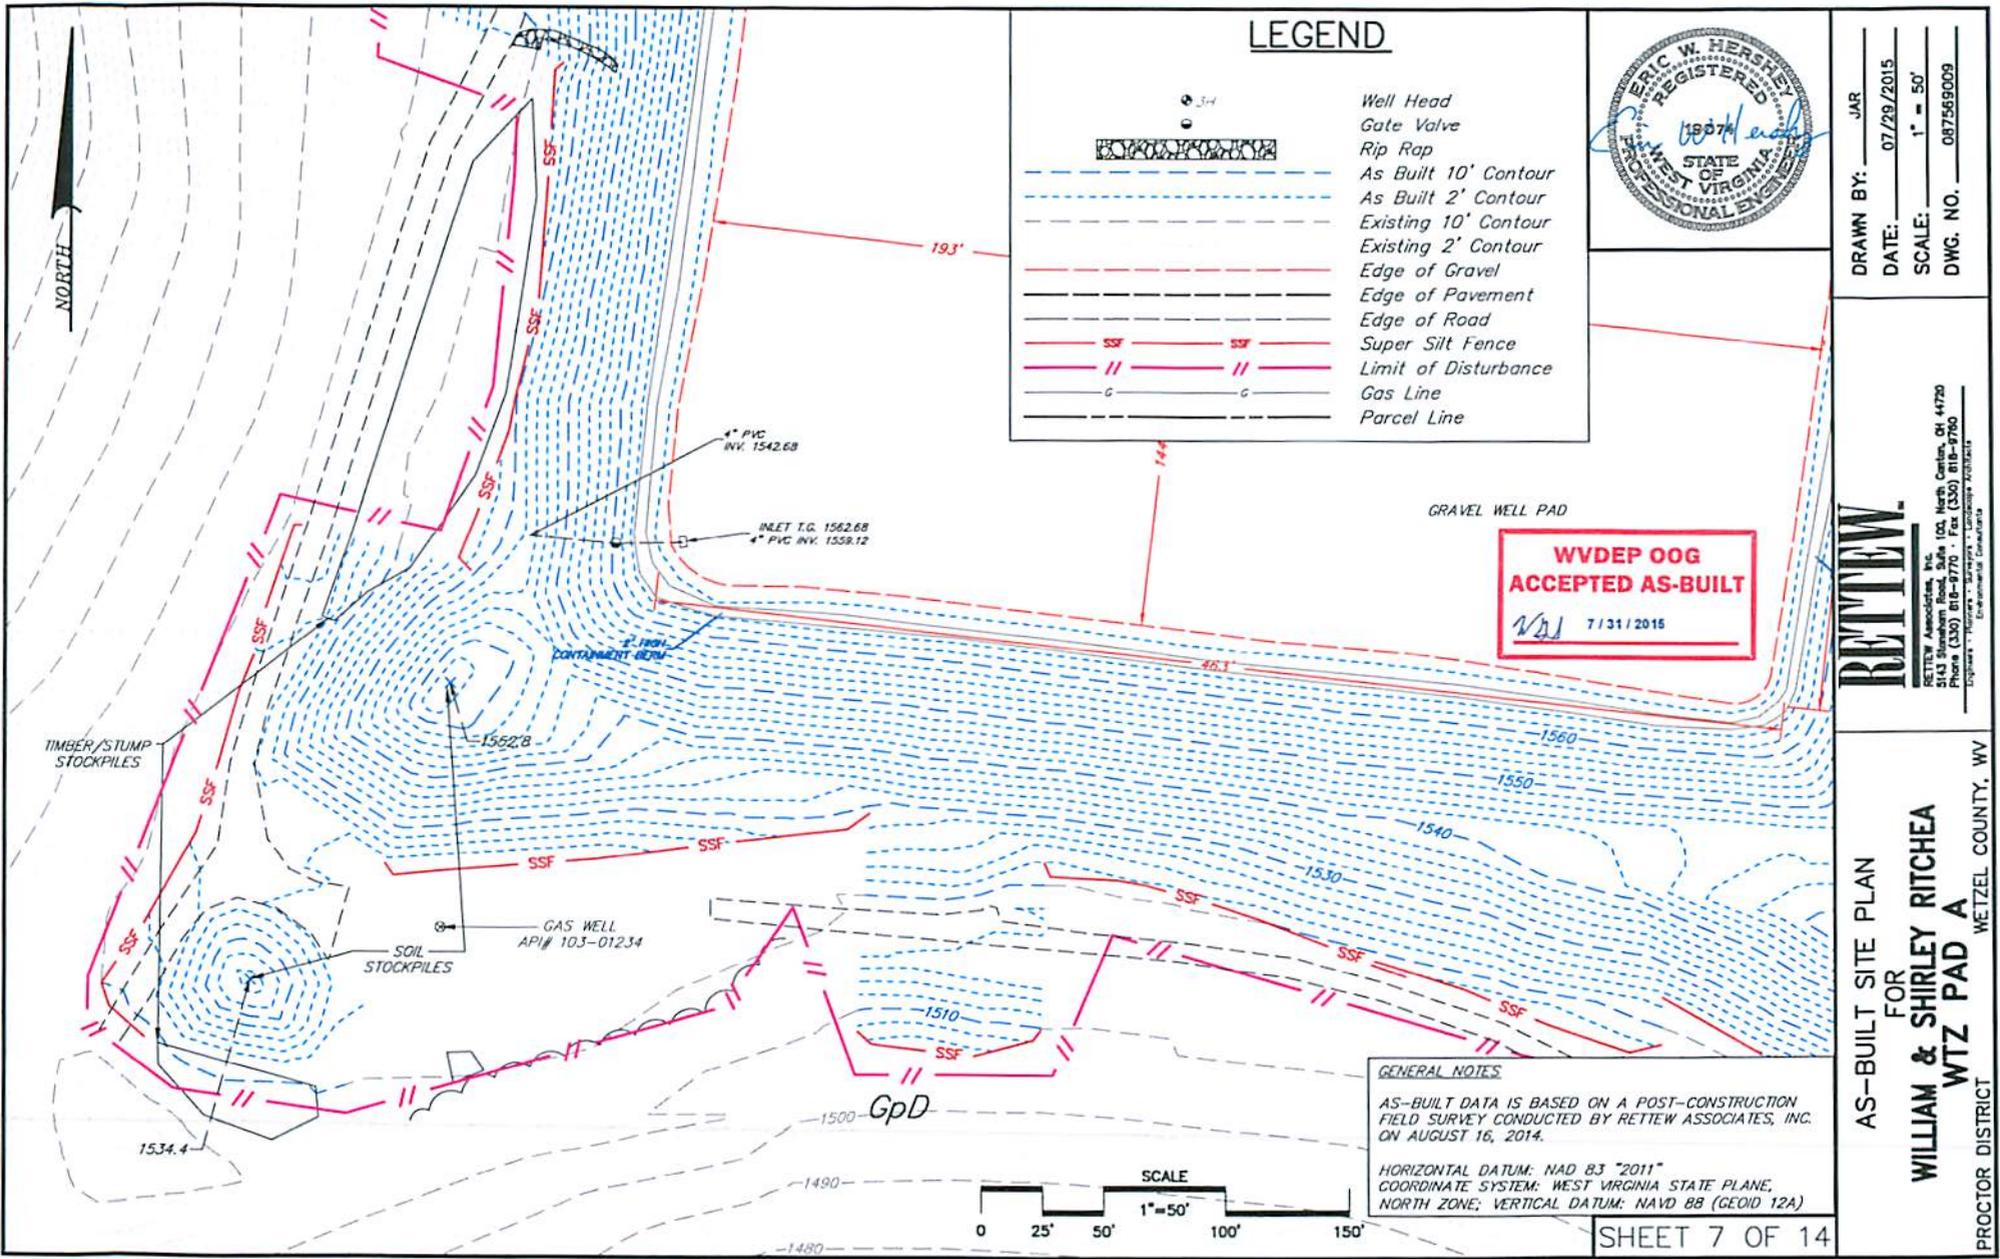

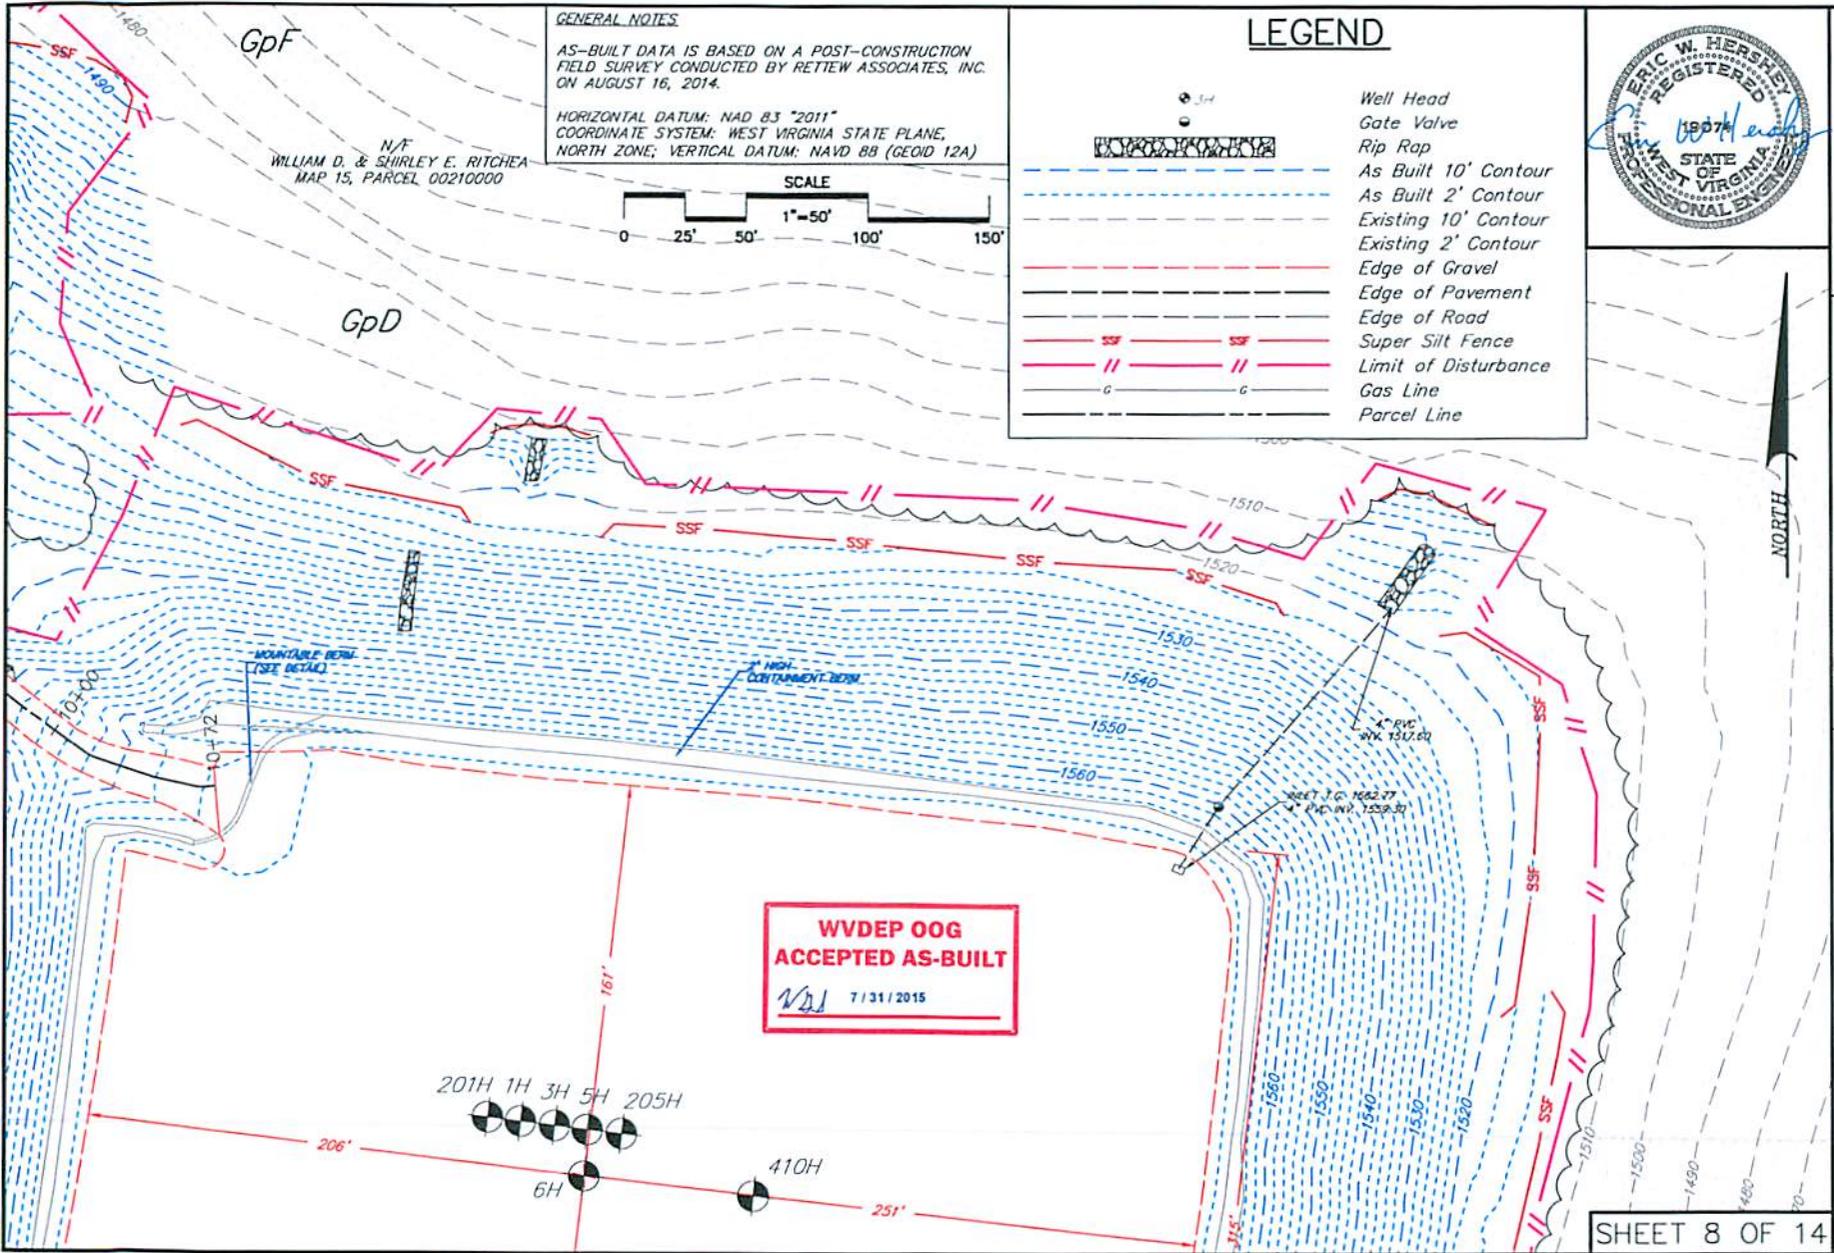

GpF  
 N/A  
 WILLIAM D. & SHIRLEY E. RITCHEA  
 MAP 15, PARCEL 00210000

**GENERAL NOTES**  
 AS-BUILT DATA IS BASED ON A POST-CONSTRUCTION FIELD SURVEY CONDUCTED BY RETTEW ASSOCIATES, INC. ON AUGUST 16, 2014.  
 HORIZONTAL DATUM: NAD 83 "2011"  
 COORDINATE SYSTEM: WEST VIRGINIA STATE PLANE, NORTH ZONE; VERTICAL DATUM: NAVD 88 (GEOID 12A)

**SCALE**  
 0 25' 50' 100' 150'

**LEGEND**


- Well Head
- Gate Valve
- Rip Rap
- As Built 10' Contour
- As Built 2' Contour
- Existing 10' Contour
- Existing 2' Contour
- Edge of Gravel
- Edge of Pavement
- Edge of Road
- Super Silt Fence
- Limit of Disturbance
- Gas Line
- Parcel Line



**DRAWN BY:** JAR  
**DATE:** 07/29/2015  
**SCALE:** 1" = 50'  
**DWG. NO.:** 087569009

**RETTEW**  
 RETTEW Associates, Inc.  
 3143 Stoneham Road, Suite 100, North Canton, OH 44720  
 Phone (330) 818-9770 • Fax (330) 818-9760  
 Virginia • Kentucky • Tennessee • Louisiana • Arkansas

**AS-BUILT SITE PLAN FOR WILLIAM & SHIRLEY RITCHEA WZ PAD A**  
 PROCTOR DISTRICT WETZEL COUNTY, WV

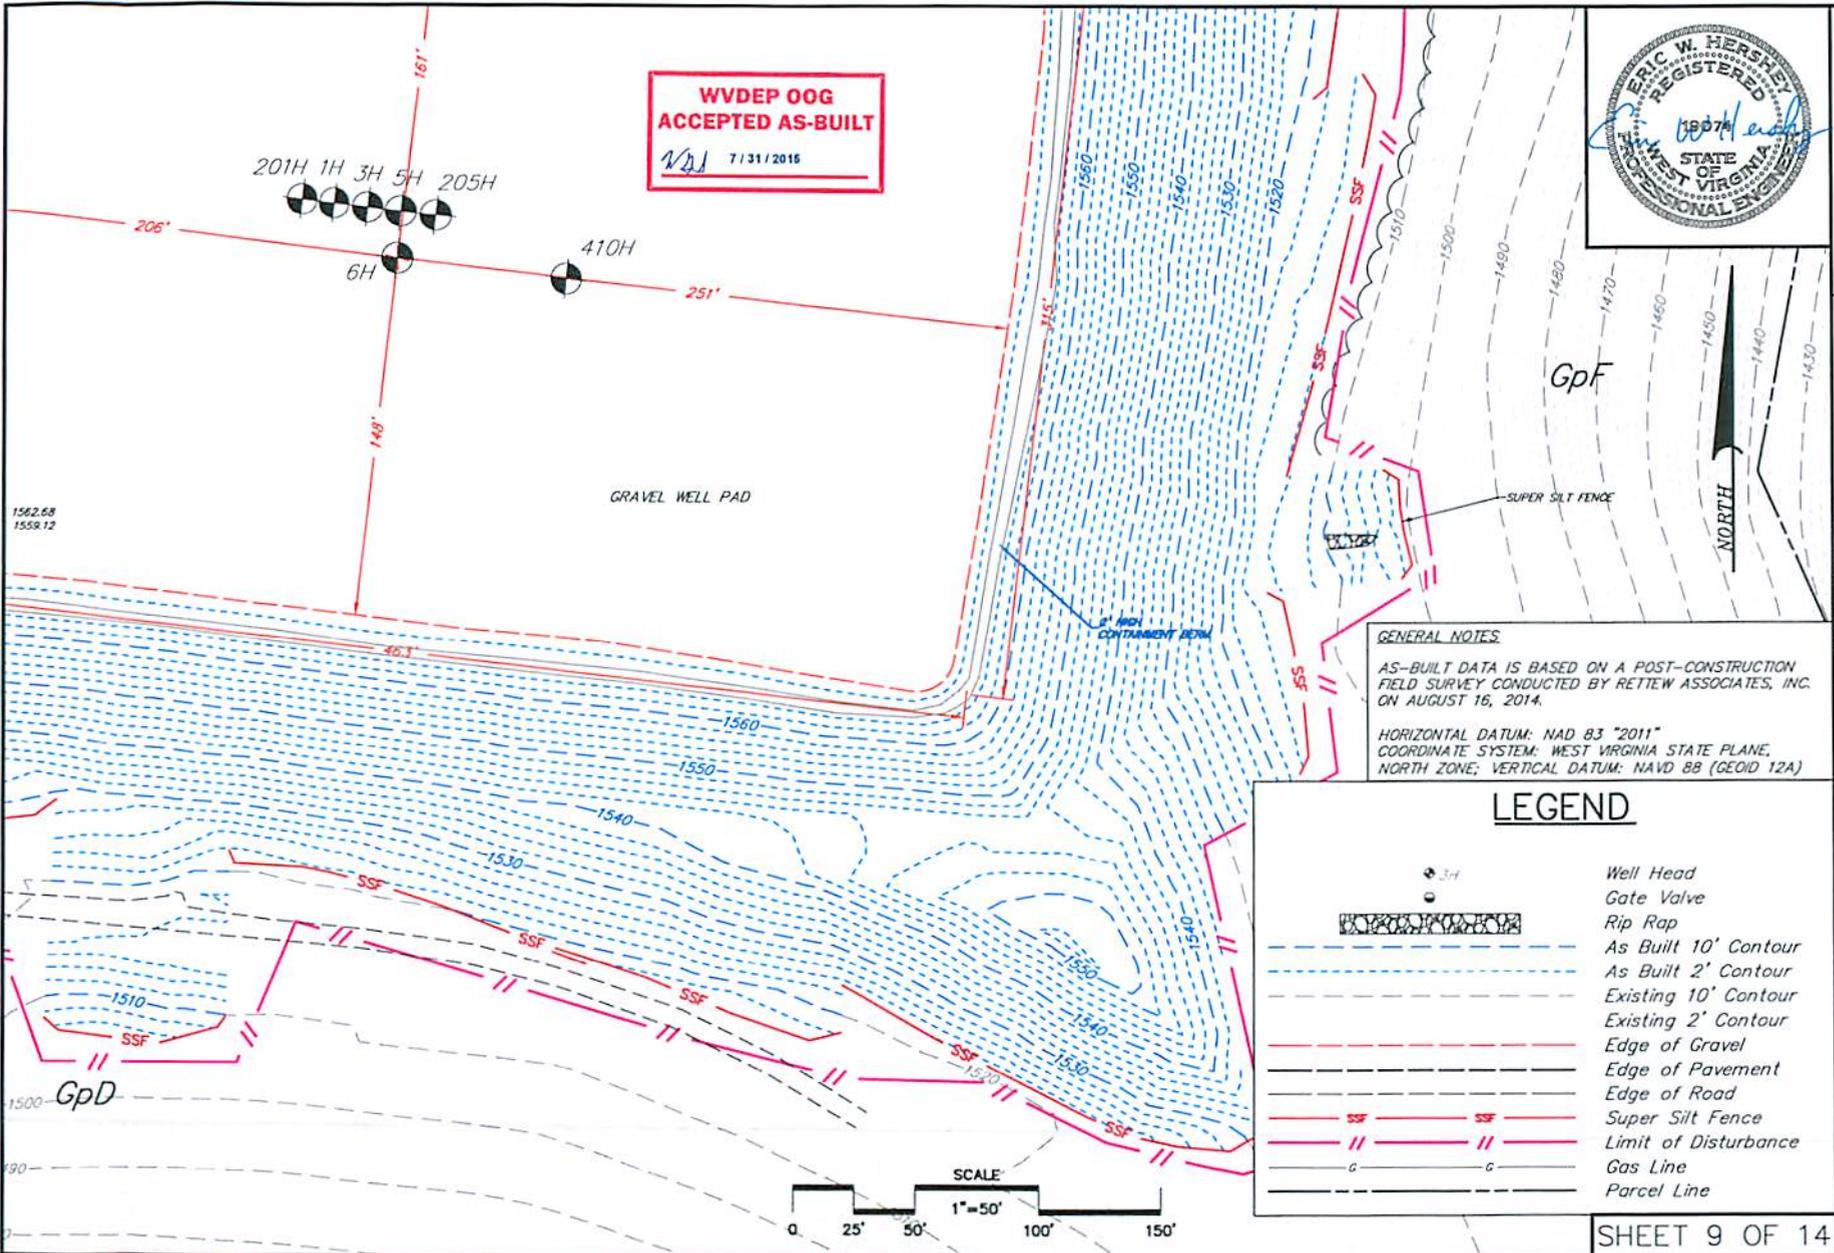


DRAWN BY: JAR  
DATE: 07/29/2015  
SCALE: 1" = 50'  
DWG. NO. 087569009

**RETTEW**  
RETTEW Associates, Inc.  
3143 Stonyham Road, Suite 100, North Canton, OH 44720  
Phone (330) 818-8770 • Fax (330) 818-8760  
Virginia • Missouri • Arkansas • Tennessee • Kentucky

AS-BUILT SITE PLAN  
FOR  
**WILLIAM & SHIRLEY RITCHEA  
WTZ PAD A**  
PROCTOR DISTRICT  
WETZEL COUNTY, WV

# AS-BUILT SITE PLAN FOR WILLIAM & SHIRLEY WTZ PAD A PROCTOR DISTRICT, WETZEL COUNTY

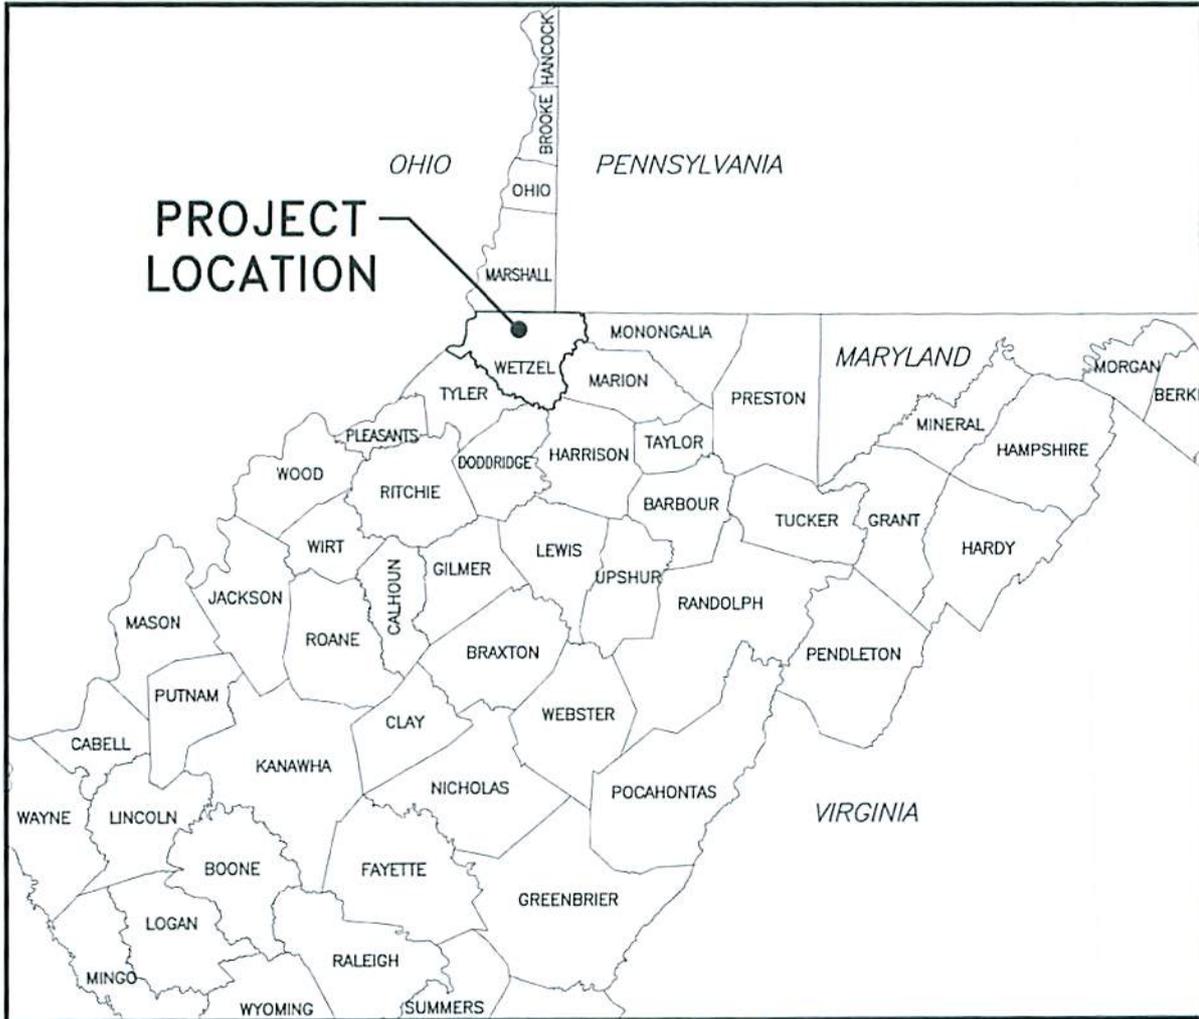

## COUNTY MAP

N.T.S.



**CALL BEFORE  
YOU DIG!**

**Dial 811 or  
800.245.4848**  
Miss Utility of West Virginia

AT LEAST 48 HOURS, BUT NOT MORE THAN 10 WORKING DAYS (EXCLUDING WEEKENDS AND HOLIDAYS), PRIOR TO STARTING ANY EARTH DISTURBANCE ACTIVITIES, ALL CONTRACTORS INVOLVED IN THESE ACTIVITIES SHALL CONTACT MISS UTILITY OF WEST VIRGINIA AT 811 OR 1-800-245-4848.

# SWN

Southwestern Energy®


### OPERATOR

SWN PRODUCTION CO., LLC  
ATTN: DEE SOUTHALL  
P.O. BOX 1300  
JANE LEW, WV 26378  
(832) 796-1614

# WILLIAM & SHIRLEY RITCHEA ARCHITECTS, WEST VIRGINIA



DRAWN BY: JAR  
 DATE: 05/28/2015  
 SCALE: AS SHOWN  
 DWG. NO. 087569009

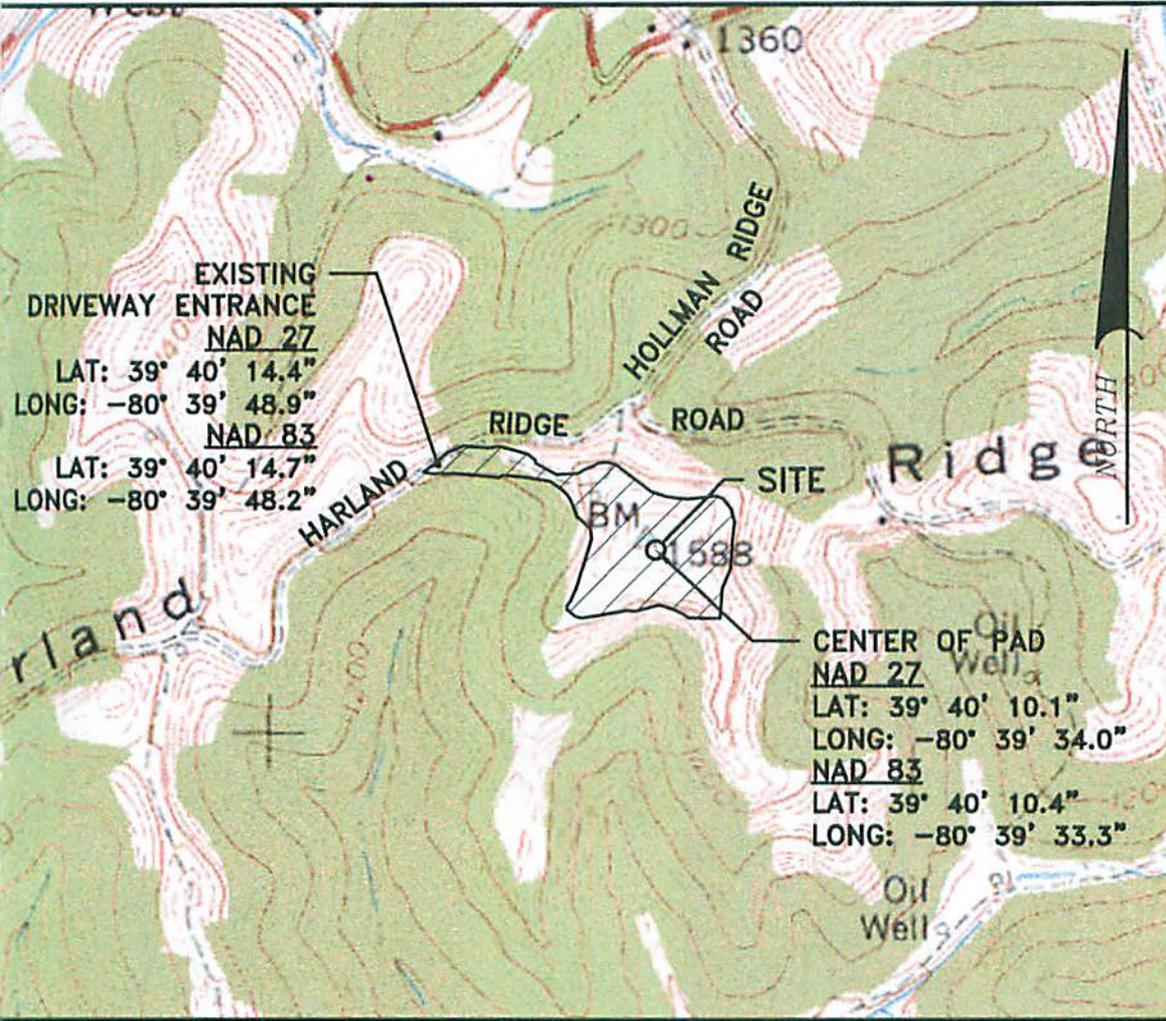

EXISTING DRIVEWAY ENTRANCE  
 NAD 27  
 LAT: 39° 40' 14.4"  
 LONG: -80° 39' 48.9"  
 NAD 83  
 LAT: 39° 40' 14.7"  
 LONG: -80° 39' 48.2"

CENTER OF PAD  
 NAD 27  
 LAT: 39° 40' 10.1"  
 LONG: -80° 39' 34.0"  
 NAD 83  
 LAT: 39° 40' 10.4"  
 LONG: -80° 39' 33.3"

## LOCATION MAP

SCALE - 1"=1000'

## SITE DATA

TOTAL DISTURBED AREA: 13.6 ACRES  
 ROAD DISTURBED AREA: 3.9 ACRES  
 PAD DISTURBED ACRES: 9.7 ACRES  
 ACCESS ROAD LENGTH: 1,079'  
 ACCESS ROAD AVERAGE WIDTH: 24'  
 WELL PAD ELEVATION: 1,563.0'

## LIST OF DRAWINGS

- 1 OF 13. . . . . COVER SHEET
- 2-3 OF 13 . . . . .EVACUATION ROUTE/ PREVAILING WINDS
- 4 OF 13. . . . .AS-BUILT SITE PLAN OVERVIEW
- 5-9 OF 13 . . . . .AS-BUILT SITE PLAN
- 10-12 OF 13 . . . .RECLAMATION PLAN
- 13 OF 13. . . . .DETAILS

SHEET 1 OF 13



**RETTEW**  
 RETTEW Associates, Inc.  
 5143 Stoneham Road, Suite 100, North Canton, OH 44720  
 Phone (330) 818-9770 • Fax (330) 818-9760  
 Engineers • Planners • Surveyors • Landscape Architects  
 Environmental Consultants

COVER SHEET FOR

**WILLIAM & SHIRLEY RITCHEA**  
**WTZ PAD A**

WETZEL COUNTY, WV

PROCTOR DISTRICT

Dnt  
 6-9-15  
 Received  
 Office of DEP  
 JUN 15 2015